


59

58

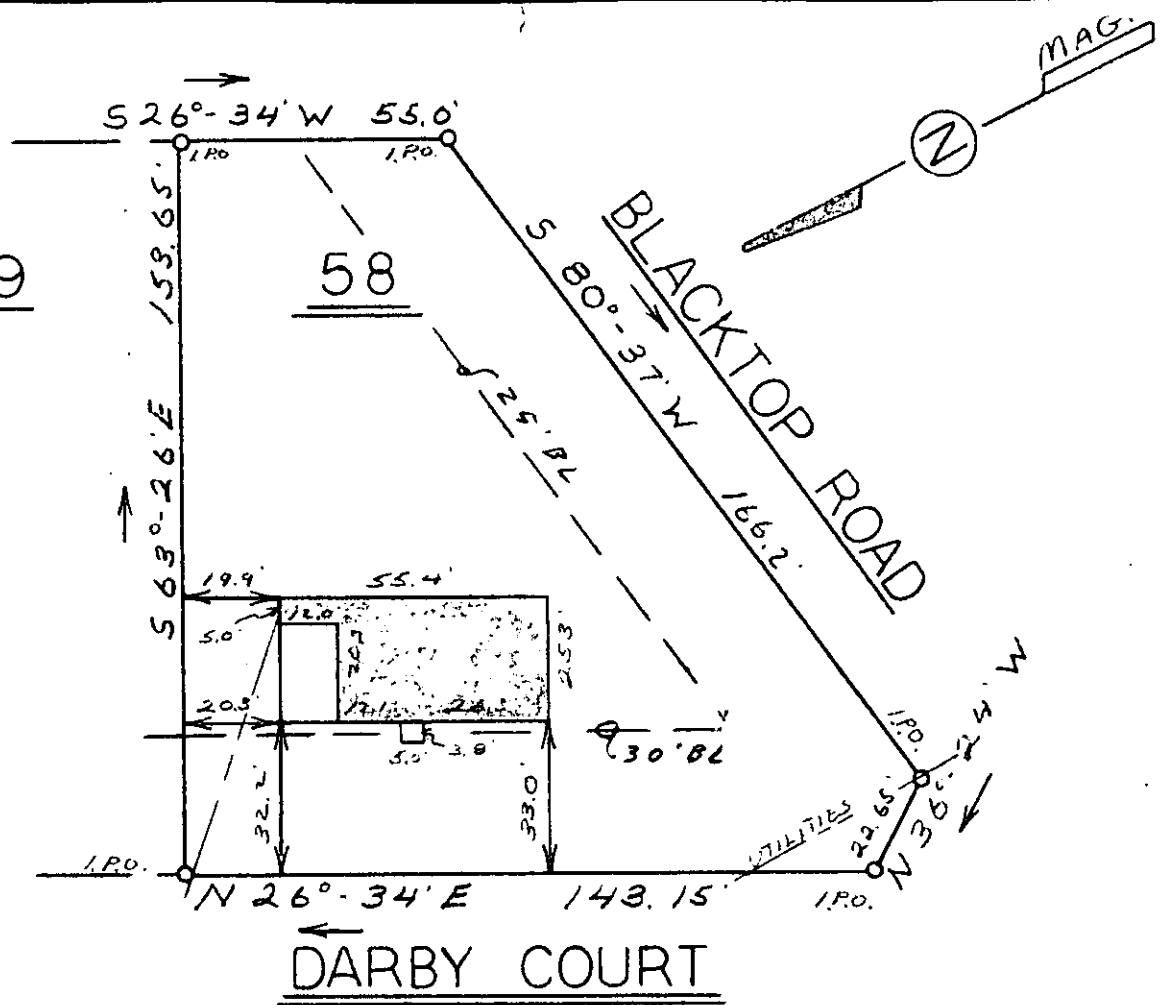

This is to certify that on November 8, 1976, I surveyed the property shown on this plat, known as Lot 58 on Plat of Chick Springs, Sec. 3, recorded in the RMC Office of Greenville County in Plat Book 4N on Page 51., and that the property lines, walls and buildings are as shown hereon; that the building located on said lot does not encroach or project on adjacent streets or property, and that no adjacent walls or buildings encroach or project on said premises, and that no utility lines cross this property except as shown hereon.

*James R. Freeland*

James R. Freeland RLS & PE 4781

MICROFILMED

1.00 per -

FILED  
 GREENVILLE, S.C.  
 12 05 PM '76  
 S. TANKERSLEY  
 REC'D

5-2-18 ✓ # 15667-A.


**STATE OF SOUTH CAROLINA  
 GREENVILLE COUNTY**

FREELAND & ASSOCIATES  
 Engineers • Land Surveyors

GREENVILLE, S. C.

CHICK SPRINGS  
SEC. 3 - LOT 58  
PROPERTY OF  
JAMES A. KAY JR.  
BONNIE S KAY

SURVEY	D.G.
DRAWN	M.C.
CHECK	B.H.
SCALE	1" = 40'
DATE	11-8-76
DWG. NO.	76-123B

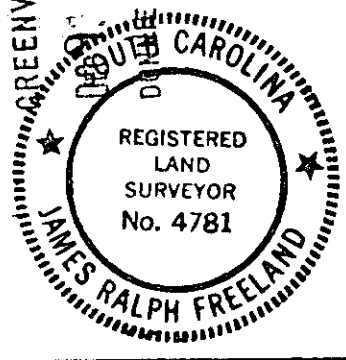

SEAL