

FILED
GREENVILLE CO. S. C.

DEC 16 3 19 PM '76


DONNIE S. TANKERSLEY
R.M.C.

- 56 -

- 55 -

- 54 -

NOTE: Improvements on
this lot are not
in a flood hazard
area.

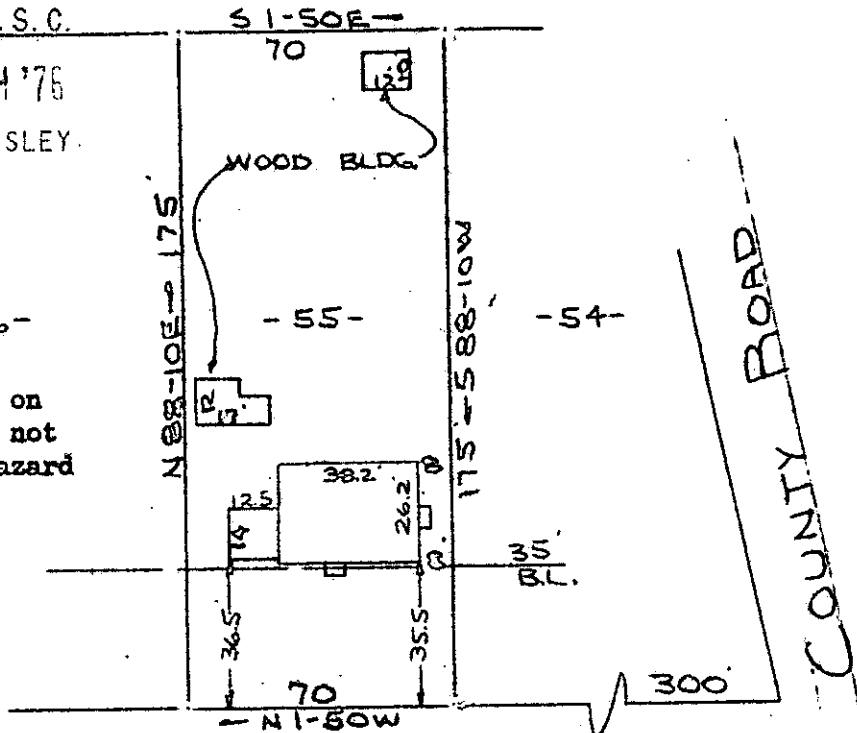

KENT LANE
WATER & SEWER IN ST. R/W

PROPERTY OF
THOMAS E. DAVIS & LEIGH ANN DAVIS
GREENVILLE S.C.
SCALE: 1" = 50' 6 DEC. 1976

This is to certify that on the 6th day of December 1976, I surveyed the property shown on this plat, being known as lot 55 on plat of VISTA HILLS and recorded in the REC Office Greenville County, S. C., in Plat Book " P " at Page 149; and that the property lines, walls and buildings are as shown hereon, and that the walls and buildings located on said lot do not encroach or project on adjacent street or property, and that no adjacent walls or buildings encroach or project on said premises, and no power lines cross this property except as shown hereon.

R. B. Bruce


R. B. Bruce, RLS #1952

CAROLINA SURVEYING
112 Manly
Greenville, S. C.

St. CO. 16332
C.

MICROFILMED

DEC 16 1976

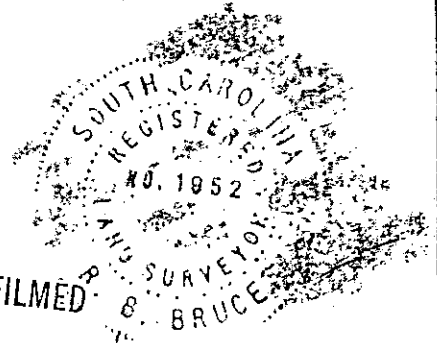

1852661 16M

1.00 AS

52-38