


FILED
 GREENVILLE CO. S. C.
 DEC 30 4 19 PM '76
 DONNIE S. TANKERSLEY
 R.M.C.

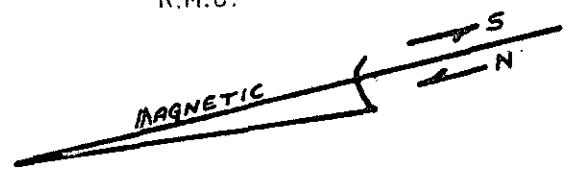

NOTE
 5' DRAINAGE EASEMENT
 ALONG ALL REAR AND SIDE
 LOT LINES.

BARRETT DRIVE

PROPERTY FOR
 PAUL H. CAMPBELL JR
 AND
 CARLENE V. CAMPBELL
 MAULDIN, SOUTH CAROLINA
 SCALE 1"=40' DEC 27, 1976

This is to certify that on December 27, 1976, I surveyed the property shown on this plat, known as Lot No. 91 of Burdett Estates as shown on a plat recorded in the RMC Office for Greenville Co. in Plat Book 4X at page 60, and that the property lines, walls and building are as shown hereon, and that the building located on said lot does not project nor encroach on adjacent streets or property, and that no adjacent walls or buildings project nor encroach on said lot, and that no utility lines cross this lot except as may be shown hereon.

52-56
 DEC 30 '76

17629

SOUTH CAROLINA REGISTERED SURVEYORS, INC.
 Survey by Campbell & Clarkson
 Surveyors, Inc.
 MICROFILMED
 S. C. R. L. S. No. 4678

503200 300

1.00 M4