

FILED
GREENVILLE CO. S. C.

FEB 14 1 29 PM '77


DONNIE S. TANKERSLEY
R.M.C.

30

29

28

4 2 1 2 5 7 7 4 1 0 0 4

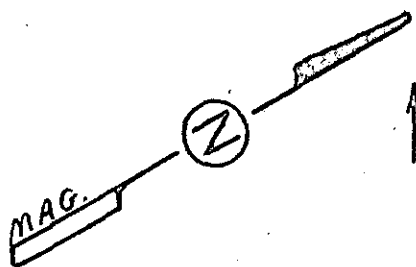

UTILITIES

N 60° 07' W 150.0

N 29° 53' E 80.0

S 60° 07' E 150.0

S 29° 53' W 80.0

195 TO SHARON DR

PARKINS MILL ROAD

This property does not lie in a major flood plain.

This is to certify that on February 9, 1976, I surveyed the property shown on this plat, known as lot 29 on plat of Property of Ethyl Chloe Baltz, recorded in the R.M.C. Office of Greenville County in Deed Book 969 on Page 491, and that the property lines, walls, and buildings are as shown hereon; that the building located on said lot does not encroach or project on adjacent streets or property, and that no adjacent walls or buildings encroach or project on said premises; and that no utility lines cross this property except as shown hereon.

21438
✓ 6-A-34 FEB 14 '77

James R. Freeland
James R. Freeland, RLS 4781

MICROFILMED



SEAL

**STATE OF SOUTH CAROLINA
GREENVILLE COUNTY**
ETHEL CHLOE BALTZ PROPERTY
LOT 29
PROPERTY OF
RONALD W. LIVELY
REBECCA R. LIVELY

FREELAND & ASSOCIATES
Engineers • Land Surveyors

GREENVILLE, S. C.

SURVEY	MC
DRAWN	MC
CHECK	JF
SCALE	1" = 30'
DATE	2-9-77
DWG. NO.	77-1380