


8938 WALK SIM

1.00 AS

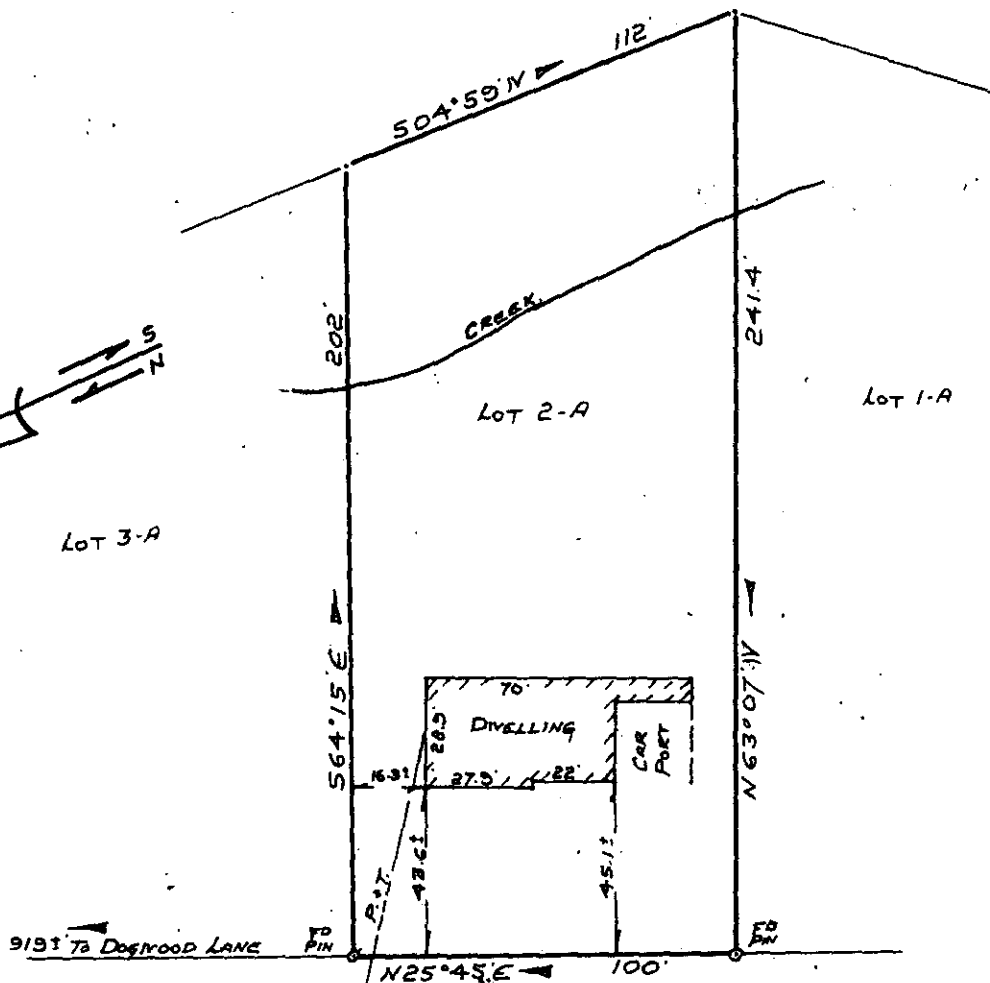

DUNHAM BRIDGE ROAD.

PROPERTY FOR  
**WILLIAM L. BUCHANAN**  
 AND  
**LILLIAN H. BUCHANAN**  
 NEAR GREENVILLE, SOUTH CAROLINA  
 SCALE 1" = 50' MAR. 31, 1977

This is to certify that on March 31, 1977, I surveyed the property hereon and the lines are as shown, and encroachment does not exist except as shown.

Reference: Deed Book 1006-525  
 Plat Book UUU-179  
 Block Map 243-2-1.4

This property is located within a flood hazard area.

✓  
 DONNIE S. TANKERSLEY  
 R.M.C.  
 MAR 31 5 00 PM '77  
 GREENVILLE, S.C.

26013

6-B-33

Survey by Campbell & Clarkson  
 Surveyors, Inc.

SOUTH CAROLINA REGISTER  
 R. P. [Signature]  
 S. C. R. L. S. No. [ ]  
 MICROFILMED  
 MAR 31 1977

FILED  
 GREENVILLE, S.C.  
 MAR 31 5 01 PM '77  
 DONNIE S. TANKERSLEY  
 R.M.C.