
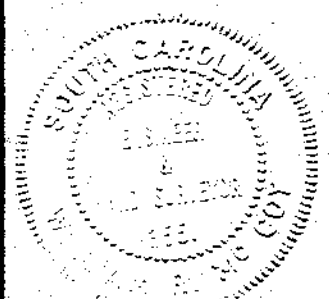


NOTES:

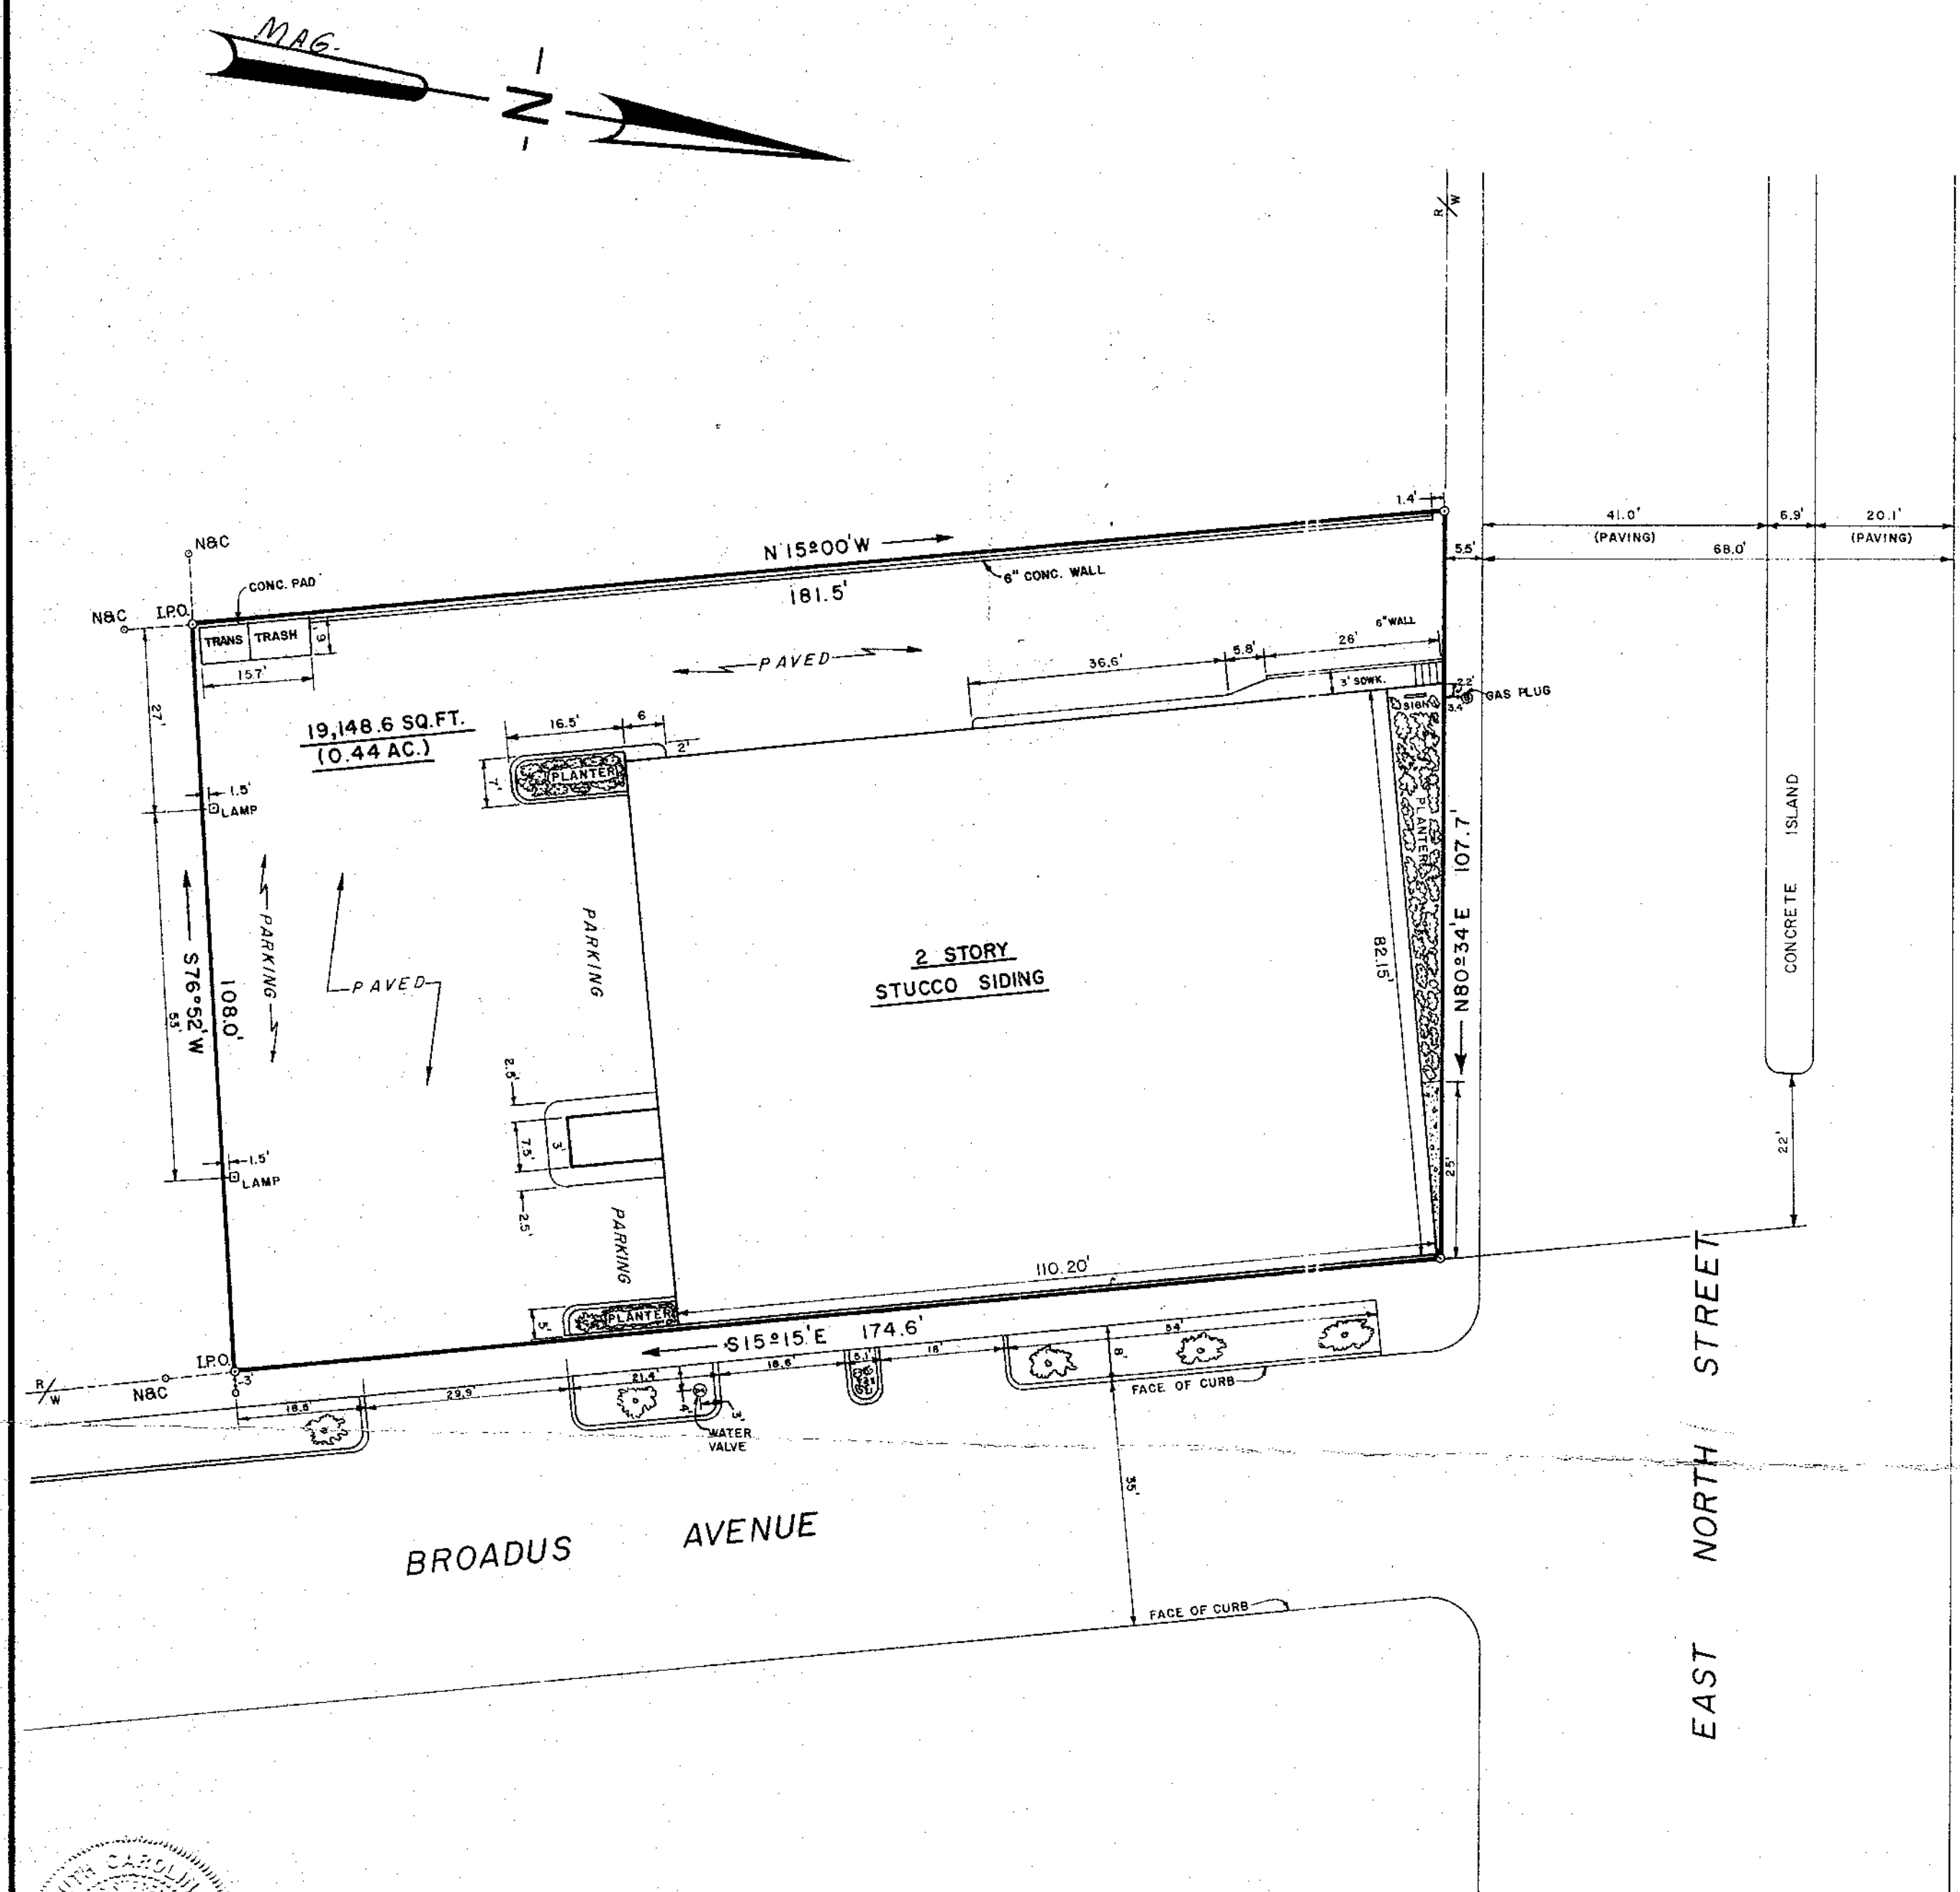

I HEREBY CERTIFY THAT THE RATIO OF PRECISION OF THE FIELD SURVEY IS 1/8,200 AS SHOWN HEREON AND THE AREA WAS DETERMINED BY D.M.D. METHOD OF AREA CALCULATION.

*William M. Wilson*  
 SURVEYORS SIGNATURE      3557      July 5, 1977  
 SURVEYORS No.      DATE

NOTE:  
 THIS PROPERTY DOES NOT LIE WITHIN FLOOD PLAIN AREA.

GREENVILLE CO., S.C.  
 AUG 1 12 07 PM '77  
 DONNIE S. TANKERSLEY  
 R.M.C.

REV.	DATE	BY	DESCRIPTION	APP.

SURVEY FOR  
**ROBERT LYNN &  
 NANCY SITTON YEARGIN  
 TRUST**

GREENVILLE COUNTY      SOUTH CAROLINA

enwright associates, inc.  
 engineers planners surveyors  
 GREENVILLE, SOUTH CAROLINA

W.E.F. DRAWN	G.O. DESIGN	G.O. CHECK	FILE	RETIRED
7-5-77	1"=20'	77512		
DATE	SCALE	DWG. NO.		