
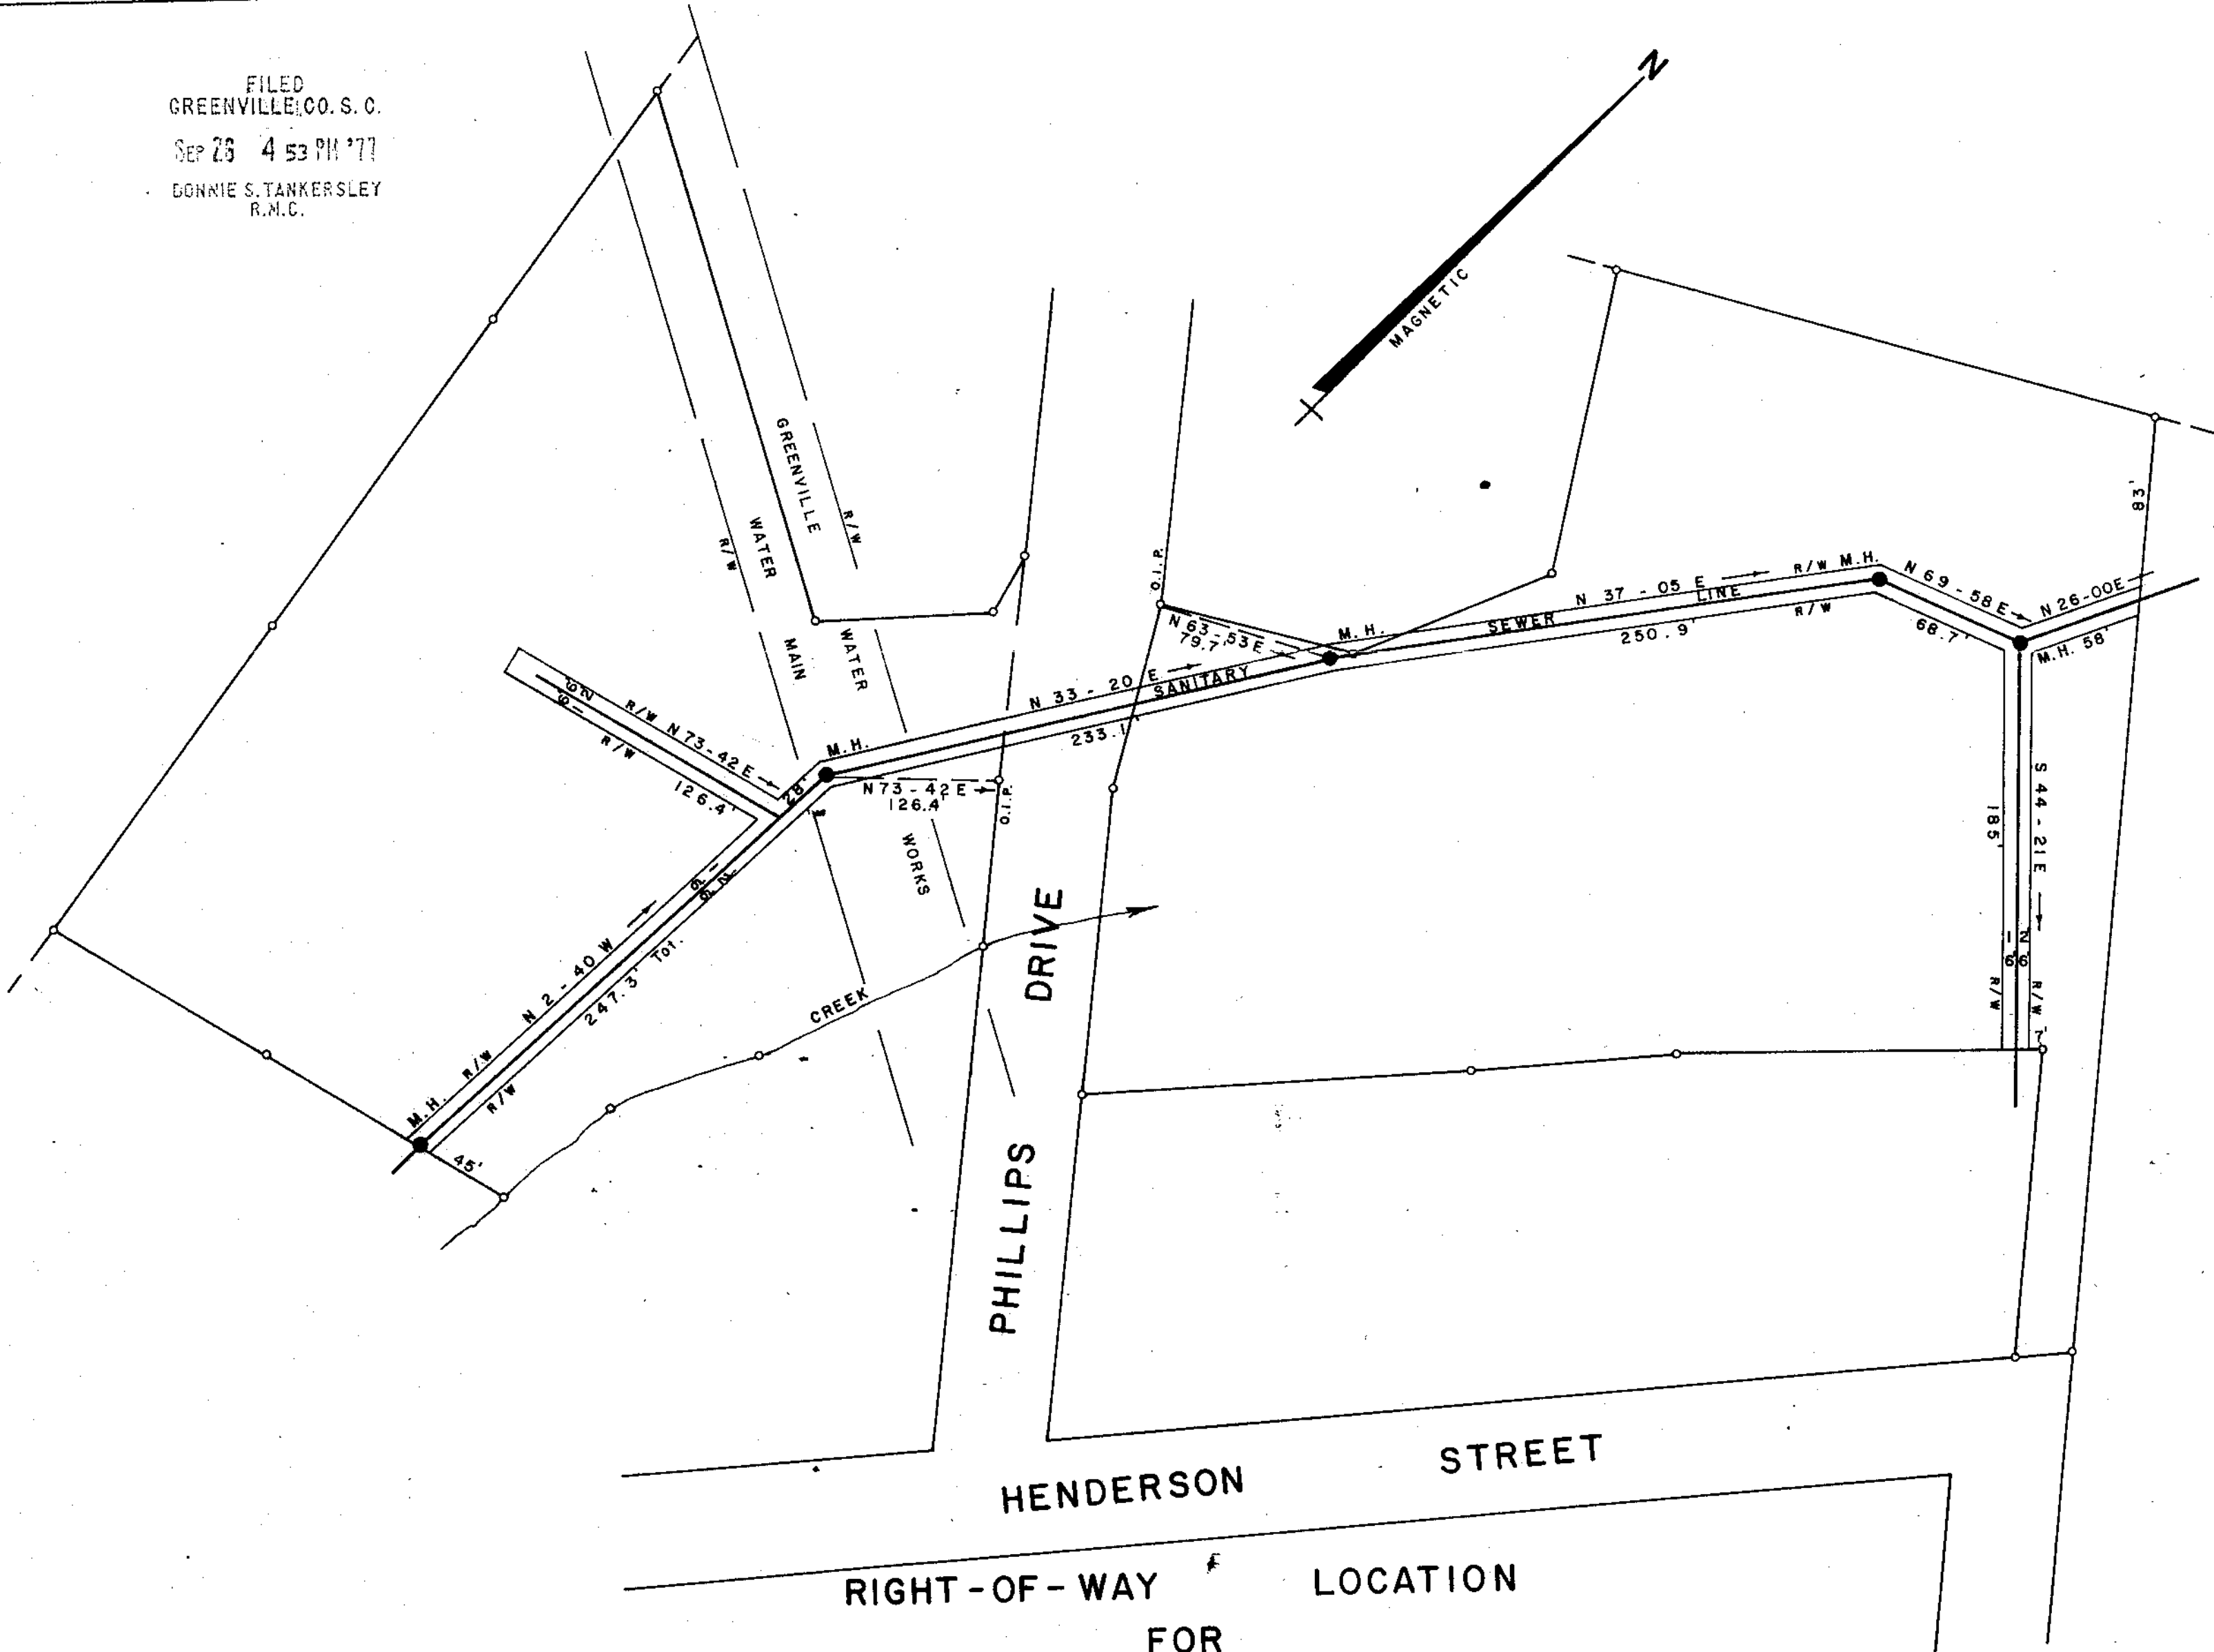


FILED  
 GREENVILLE, CO. S. C.  
 SEP 26 4 53 PM '77  
 BONNIE S. TANKERSLEY  
 R.M.C.

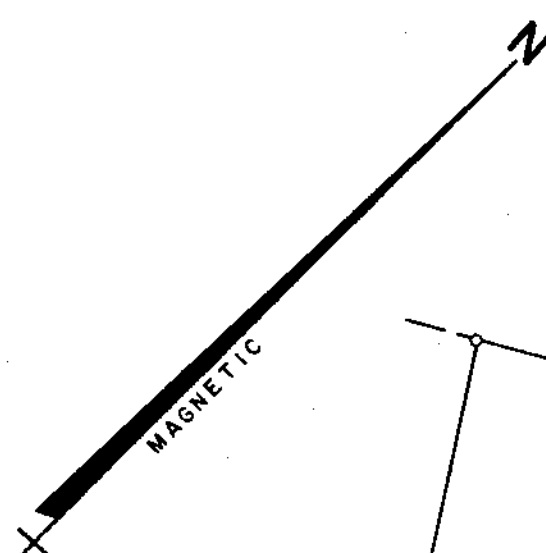

RIGHT-OF-WAY LOCATION  
 FOR  
**HOYT L. WALTERS**  
 TRAVELERS REST GREENVILLE CO.  
 SOUTH CAROLINA  
 AUGUST 29, 1977 9725

16C-67

SEP 6 1977

MICROFILMED

W. R. WILLIAMS JR. ENGR. / SURVEYOR # 3979

15 SOUTH ... STREET  
 TRAVELERS REST, S. C.

495-1-31, 37

F.B. 22

SCALE 1" = 60'