


FILED  
GREENVILLE CO. S. C.

JUN 1 10 00 AM '77

DONNIE S. TANKERSLEY  
R.M.C.

This is to certify that on May 30, 1977, I surveyed the property shown on this plat, known as Property of Boyce Ralph Hart, recorded in the RMC Office of Greenville County in Deed Book 812 on Page 151, and in Deed Book 695 on Page 255, and that the property lines, walls and buildings are as shown hereon; that the building located on said lot does not encroach or project on adjacent streets or property, and that no adjacent walls or buildings encroach or project on said premises, and that no utility lines cross this property except as shown hereon.

*James R. Freeland*  
James R. Freeland RLS & PE 4781

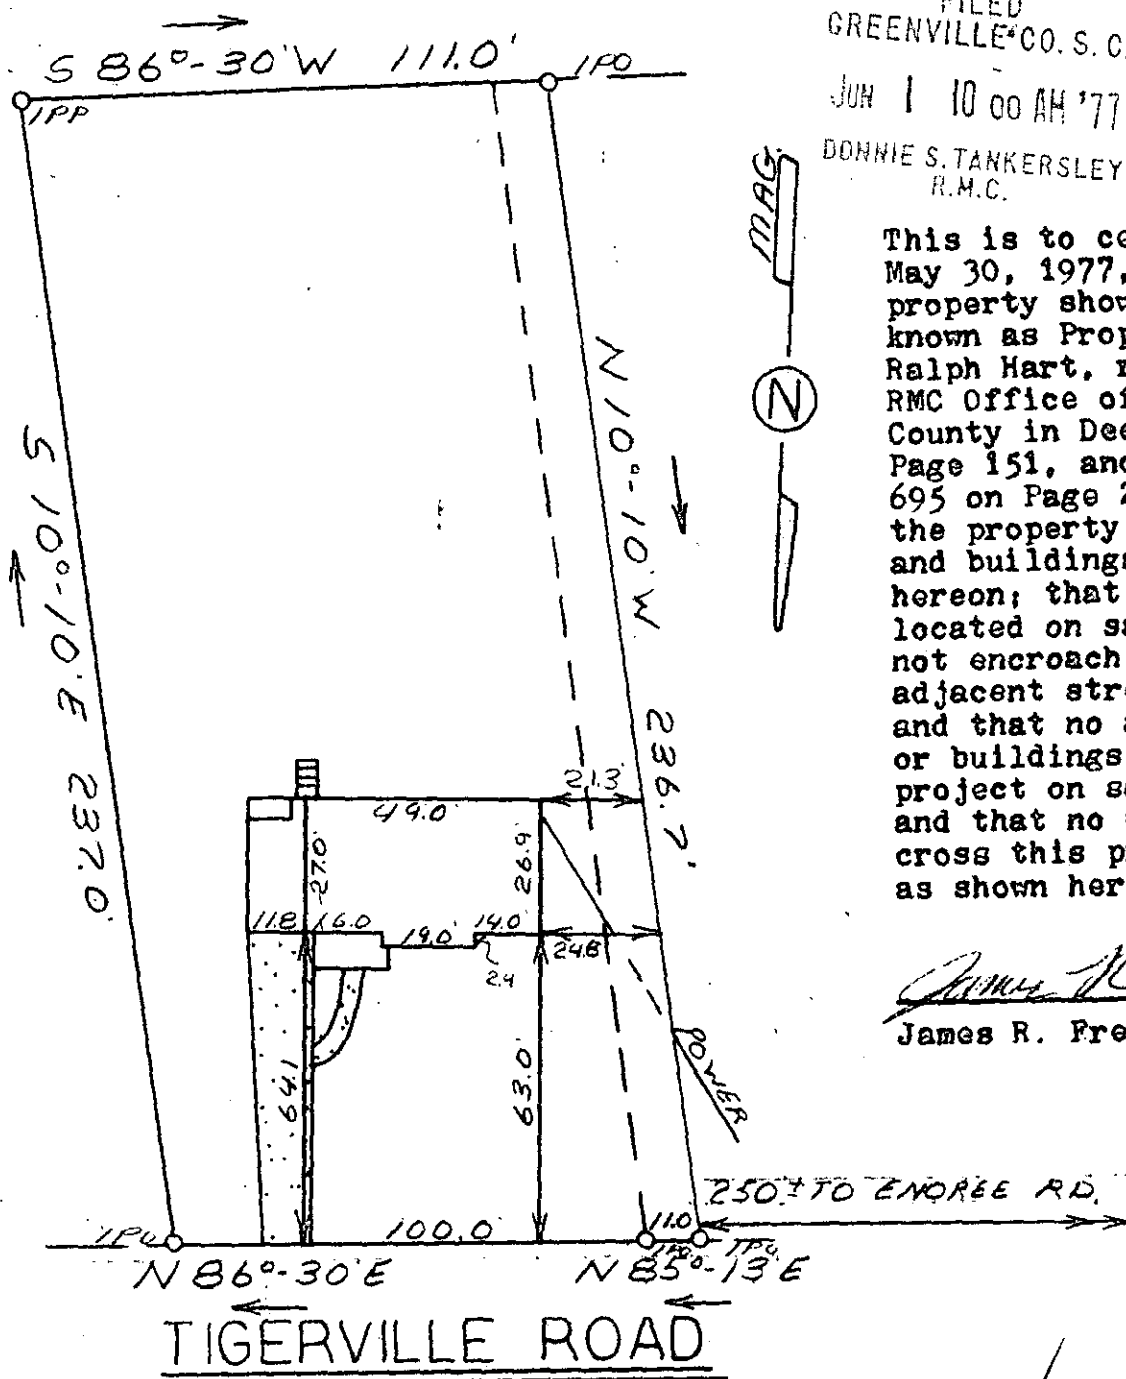

MICROFILMED

JUN 1977

6-D-88 ✓

33086



SEAL

STATE OF SOUTH CAROLINA  
GREENVILLE COUNTY

PROPERTY OF  
JOHN EDWIN MORRIS  
JANICE B. MORRIS

1 4 5 1 1 1 1 0

1.00 A

FREELAND & ASSOCIATES  
Engineers • Land Surveyors

GREENVILLE, S. C.

SURVEY *D.G.*

DRAWN *M.C.*

CHECK *J.F.*

SCALE 1" = 40'

DATE 5-30-77

DWG. NO. 77-1572