



I do hereby certify that on the 14 day of June, 1977, I surveyed the property shown on this plat, being recorded in Plat Book of the R.M.C. Office for Greenville County, S. C., and that the property lines, walls and buildings are as shown hereon; that the buildings located on said lot do not encroach or project on adjacent streets or property; and that no adjacent buildings or walls encroach or project on said premises, and that no utility lines cross this property.

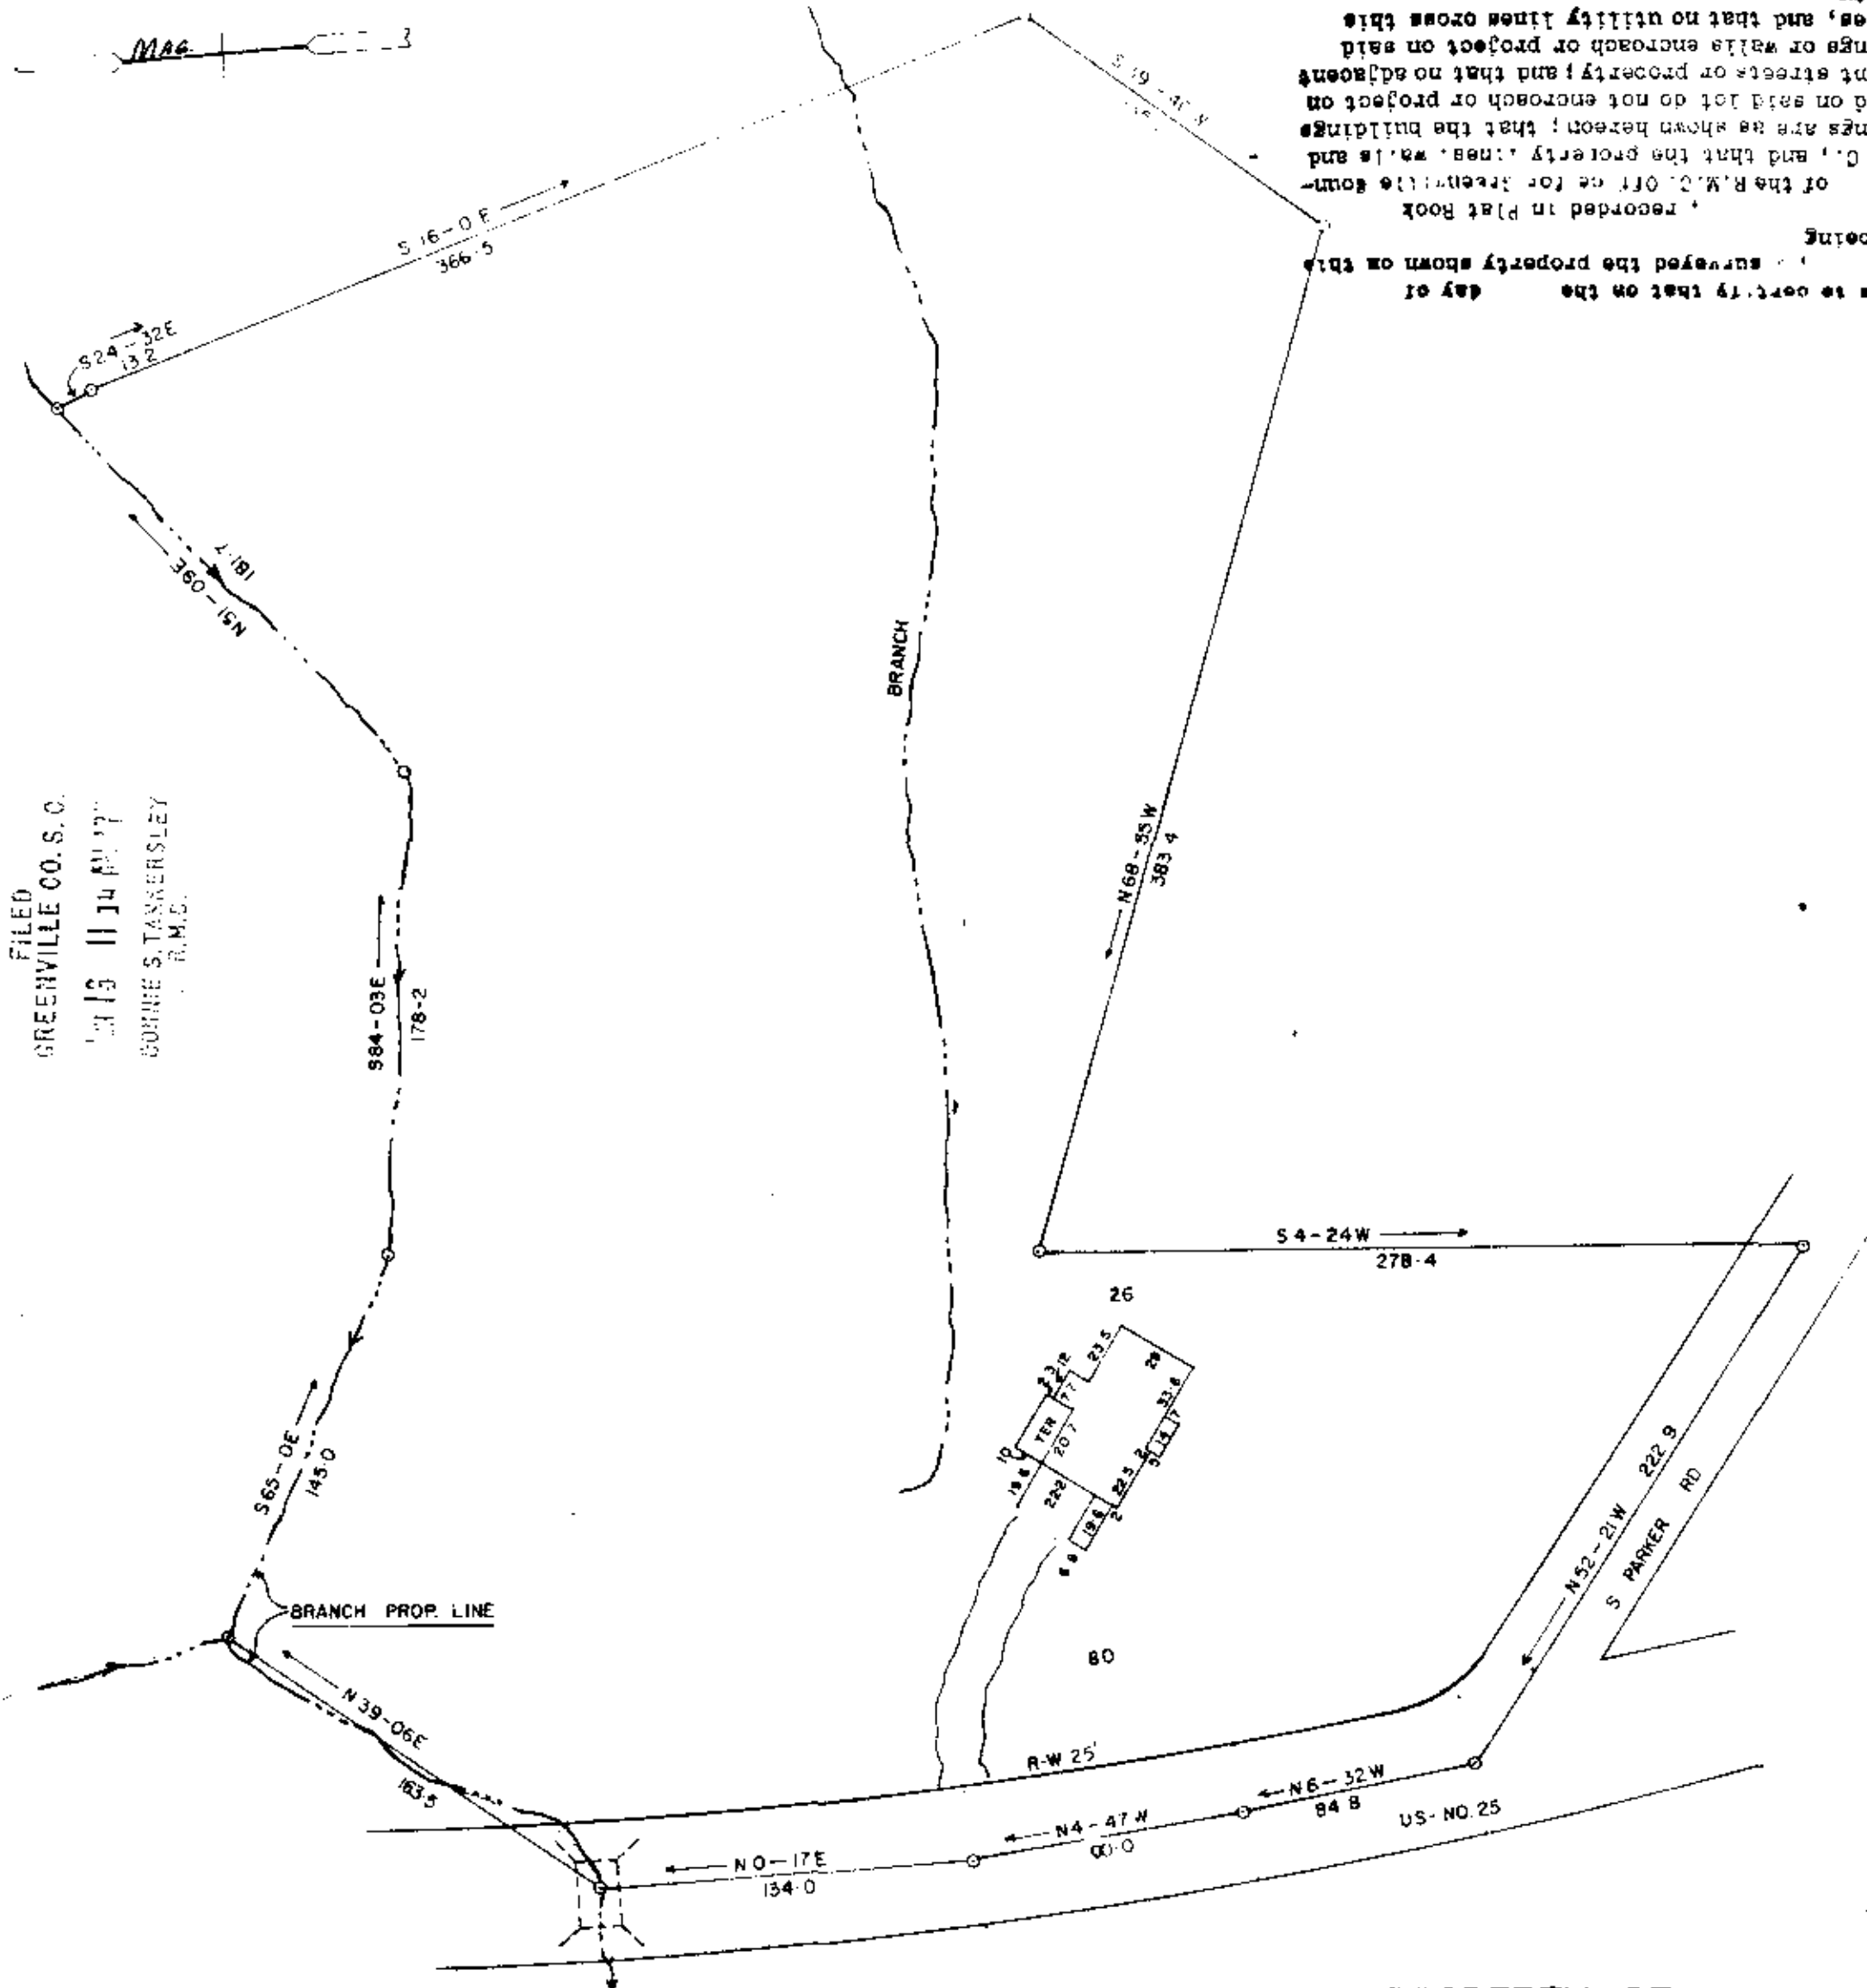

FILED  
GREENVILLE CO. S. C.  
JUN 15 11 14 AM '77  
R.M.C.

I do hereby certify that on the 14 day of JUNE 1977, I surveyed the property shown on this plat, being recorded in Plat Book of the R.M.C. Office for Greenville County, S. C., and that the property lines, walls and buildings are as shown hereon; that the buildings located on said lot do not encroach or project on adjacent streets or property; and that no adjacent buildings or walls encroach or project on said premises, and that no utility lines cross this property.

Reg. Engineer No. 1144 S.C.

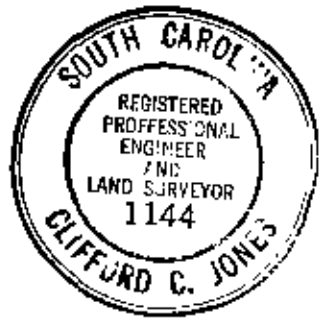

PROPERTY OF  
WENDELL R. HUDGENS  
LOIS M. HUDGENS

GREENVILLE CO, S. C.  
SCALE 1"=60' JUNE 13 1977

JUN 16 1977

6E-18

31951

MICROFILMED ED

7725 160

2.00 M