
MEADOWVIEW DRIVE

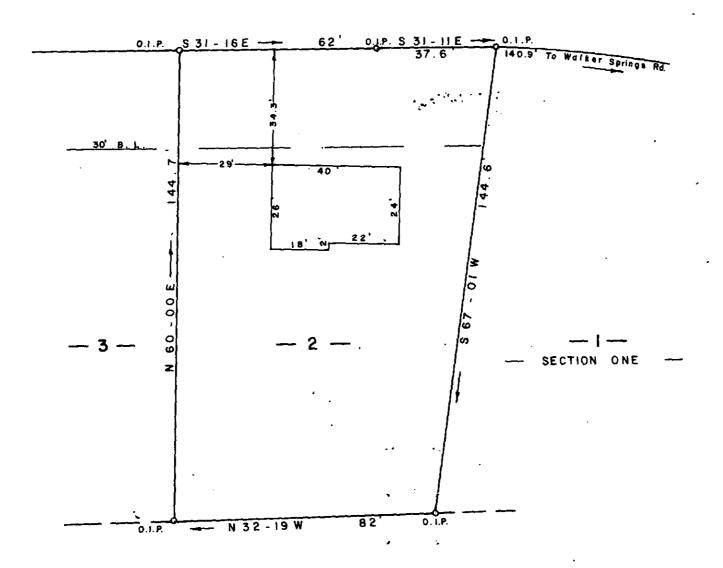

HAMMETT ---

MICROFILMED

SURVEY GEORGE Η. MARGARET **TAYLORS**

FOR BRIDGES GREENVILLE

CO

SOUTH

CAROLINA

This is to certify that on the 16th day of September, 1977, I surveyed the property shown on this plat; being the same property shown as Lot # 2, Section Two, The Meadows, recorded in R.M.C. for Greenville County in Plat Book 5P, Page 75, and that the property lines, walls and buildings are as shown hereon; that the buildings located on said property do not encroach or project on adjacent streets or property except as shown hereon; and that no adjacent buildings or walls encorach or project on said premises.

THE . MEADOWS . 10218 6-E-87

SEP 30'77

NEAR

STREET

 $2.00 \, \text{A1}$

SCALE

1297