

FILED


GREENVILLE CO. S. C.

WATTS AVE

WATER IN ST R/W

JUN 9 4 43 PM '77

DONNIE S. TANKERSLEY  
R.M.C.

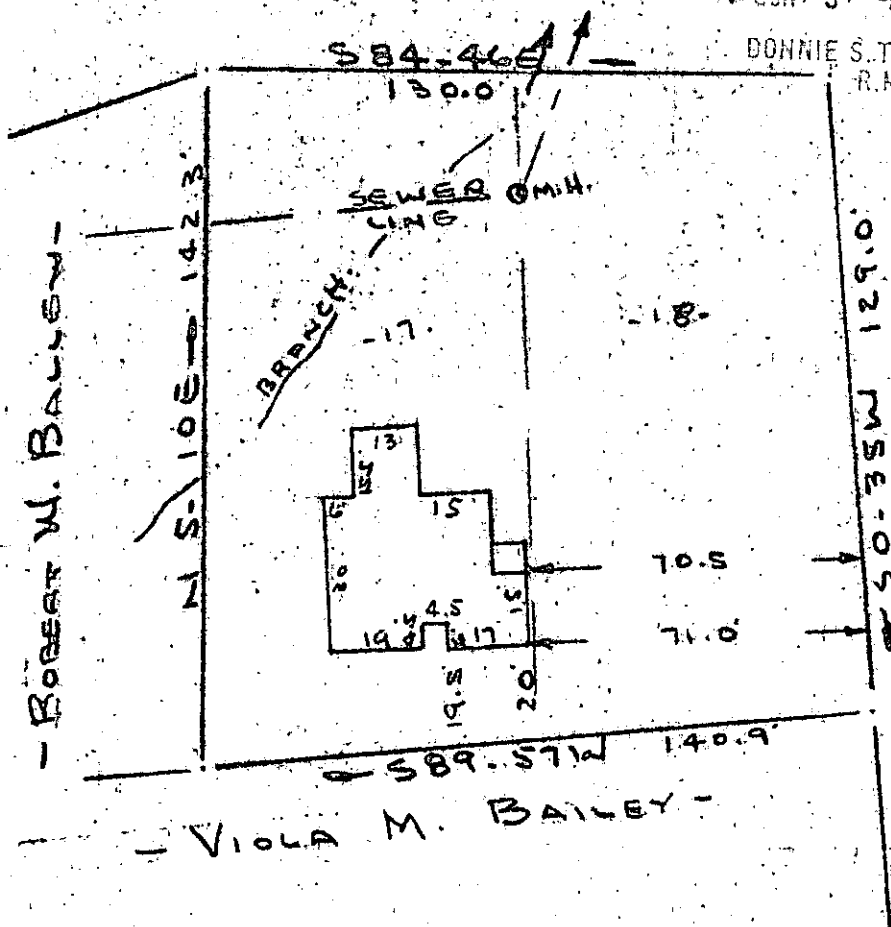

BALTIMORE STREET  
WATER IN ST R/W

NOTE: Improvements on this lot are not in a flood hazard area.

PROPERTY OF  
CALVIN N. EDWARDS JR & PATRICIA C. EDWARDS  
GREENVILLE, S. C.  
SCALE 1" = 40'      8 JUNE 1977

This is to certify that on the 8th day of June, 1977, I surveyed the property shown on this plat, being known as lots 17 & 18 on plat of STELLA K. TINDAL PROPERTY and recorded in the REC Office Greenville County, S. C., in Plat Book "H" at Page 235; and that the property lines, walls and buildings are as shown hereon, and that the walls and buildings located on said lot do not encroach or project on adjacent street or property, and that no adjacent walls or buildings encroach or project on said premises, and no power lines cross this property except as shown hereon.

*R. B. Bruce*

R. B. Bruce, RLS #1952

MICROFILMED

CAROLINA SURVEYING  
112 Manly St.  
Greenville, S. C.

CO. JUN 9 1977

6-F-7

34100

975 JUN 9E

1.00 A8

*[Signature]*