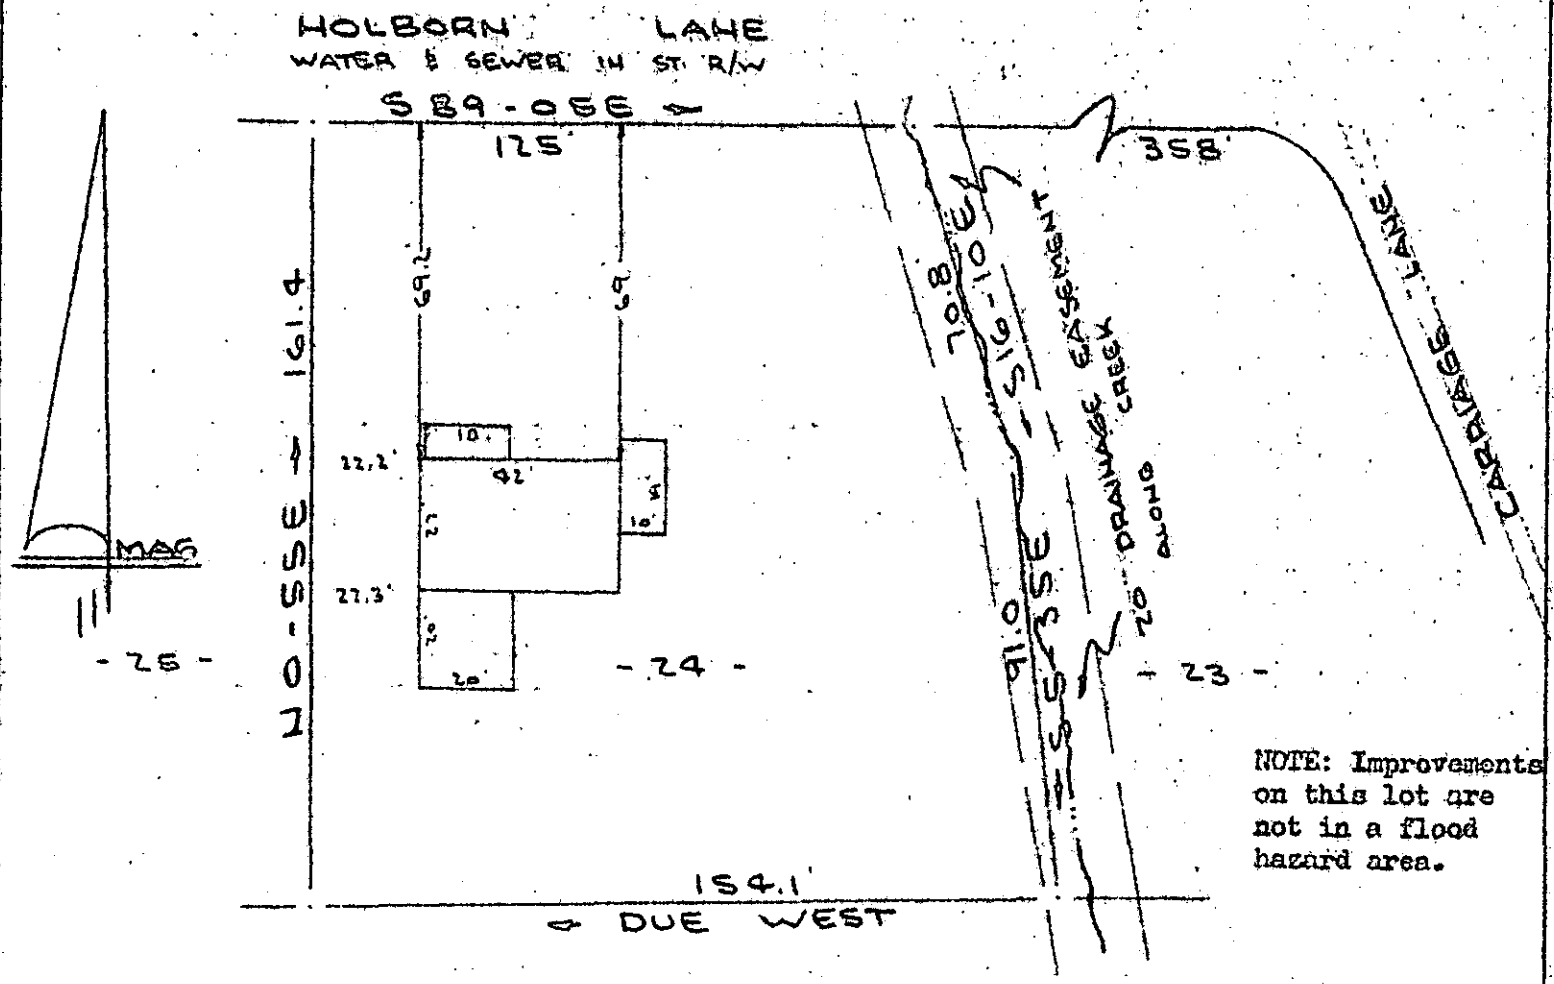

NOTE: Improvements on this lot are not in a flood hazard area.

PROPERTY OF

JOHN M. GOODE & DOREEN GOODE

NEAR GREENVILLE, S. C.

SCALE: 1" = 40' 26 JULY 1977

This is to certify that on the 26th day of July, 1977, I surveyed the property shown on this plat, being known as lot 24 on plat of EXTENSION OF SECTION ONE BROOKWOOD FOREST and recorded in the RMC Office Greenville County, S. C., in Plat Book " XX " at Page 96; and that the property lines, walls and buildings are as shown hereon, and that the walls and buildings located on said lot do not encroach or project on adjacent street or property, and that no adjacent walls or buildings encroach or project on said premises, and no power lines cross this property except as shown hereon.

FILED
GREENVILLE CO. S. C.
JUL 29 4 57 PM '77
DONNIE S. TANKERSLEY
R.M.C.

✓6G-9

3226

R. B. Bruce

R. B. Bruce, RLS #1952

SOUTH CAROLINA REGISTERED LAND SURVEYOR R. B. BRUCE

CAROLINA SURVEYING CO.
112 Manly St.
Greenville, S. C.

E 1.00 A8

JUL 29 1977

45/2 T29.1-1-26

MICROFILMED