This property is not located in a major flood plain.

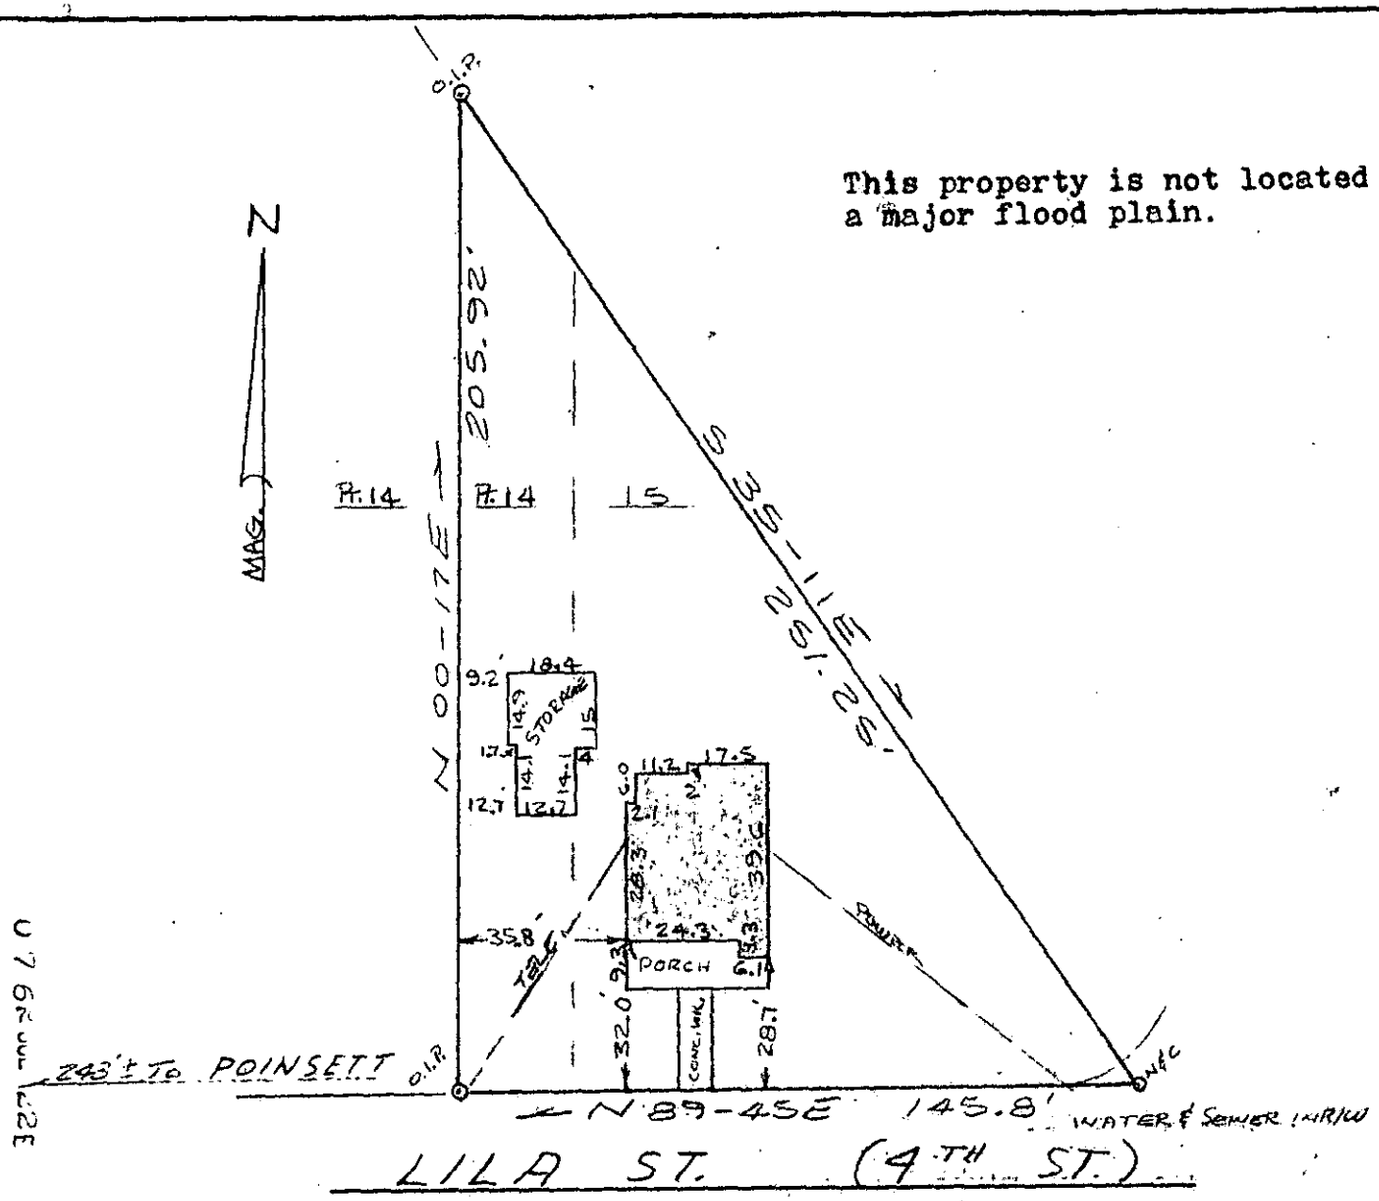

This is to certify that on August 1, 1977, I surveyed the property shown on this plat, known as lot 15 and part lot 14 on plat of Park Place, recorded in the RMC Office of Greenville County in Plat Book A on Page 119; and that the property lines, walls, and buildings are as shown hereon, that the building located on said lot does not encroach or project on adjacent streets or property, and that no adjacent walls or buildings encroach or project on said premises, and that no utility lines cross this property except as shown hereon.

3817

James R. Freeland, RLS & PE 4281

175-3-7 6-0-18 AUG 4 1977

FILED GREENVILLE CO. S. C. AUG 4 11 46 AM '77 DONNIE S. TANKERSLEY R.M.C.

SOUTH CAROLINA REGISTERED LAND SURVEYOR NO. 4781 JAMES RALPH FREELAND

SEAL

STATE OF SOUTH CAROLINA
GREENVILLE COUNTY

PARK PLACE
LOT No. 15 & Pt. 14
PROPERTY OF
CARVER L. BLASSINGAME
LORETTA L. BLASSINGAME

FREELAND & ASSOCIATES
Engineers • Land Surveyors
GREENVILLE, S. C.

MICROFILMED

SURVEY	B. H.
DRAWN	J. S.
CHECK	J. F.
SCALE	1" = 40'
DATE	8-1-77
DWG. NO.	77-1697