


SEP 6 1977

DONNIE S. TANKERSLEY
R.M.C.

N 59-56E -

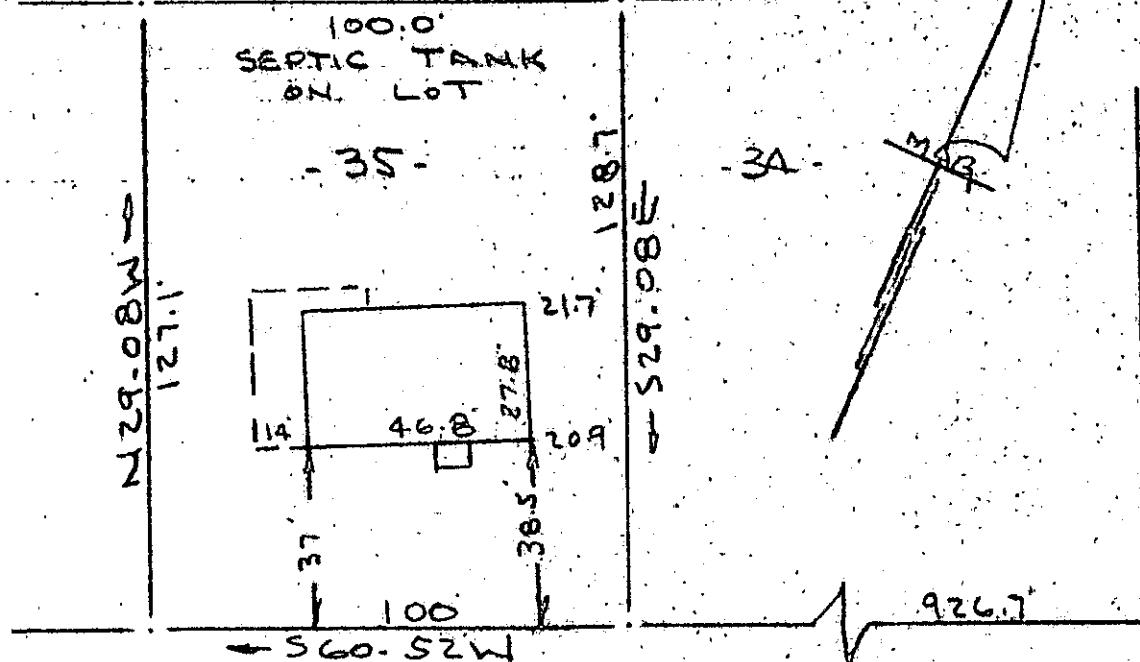

PROPERTY OF
JERRY B. STONE & JEANIE W. STONE
NEAR GREENVILLE, S.C.
SCALE 1:40 31 AUG 1977

This is to certify that on the 31st day of August, 1977, I surveyed the property shown on this plat, being known as lot 35 on plat of COCHRAH HEIGHTS also being known as PROPERTY OF JERRY B. STONE AND JEANIE W. STONE and recorded in the RMC Office Greenville County, S. C., in Plat Book at Page ; and that the property lines, walls and buildings are as shown hereon, and that the walls and buildings located on said lot do not encroach or project on adjacent street or property, and that no adjacent walls or buildings encroach or project on said premises, and no power lines cross this property except as shown hereon.

R. B. Bruce
R. B. Bruce, #13 2952

✓ 6G-79

7567

SEP 6 '77

CAROLINA SURVEYING CO.
112 Main St.
Greenville, S. C.

MICROFILMED

110 SURVEY
R. B. BRUCE