
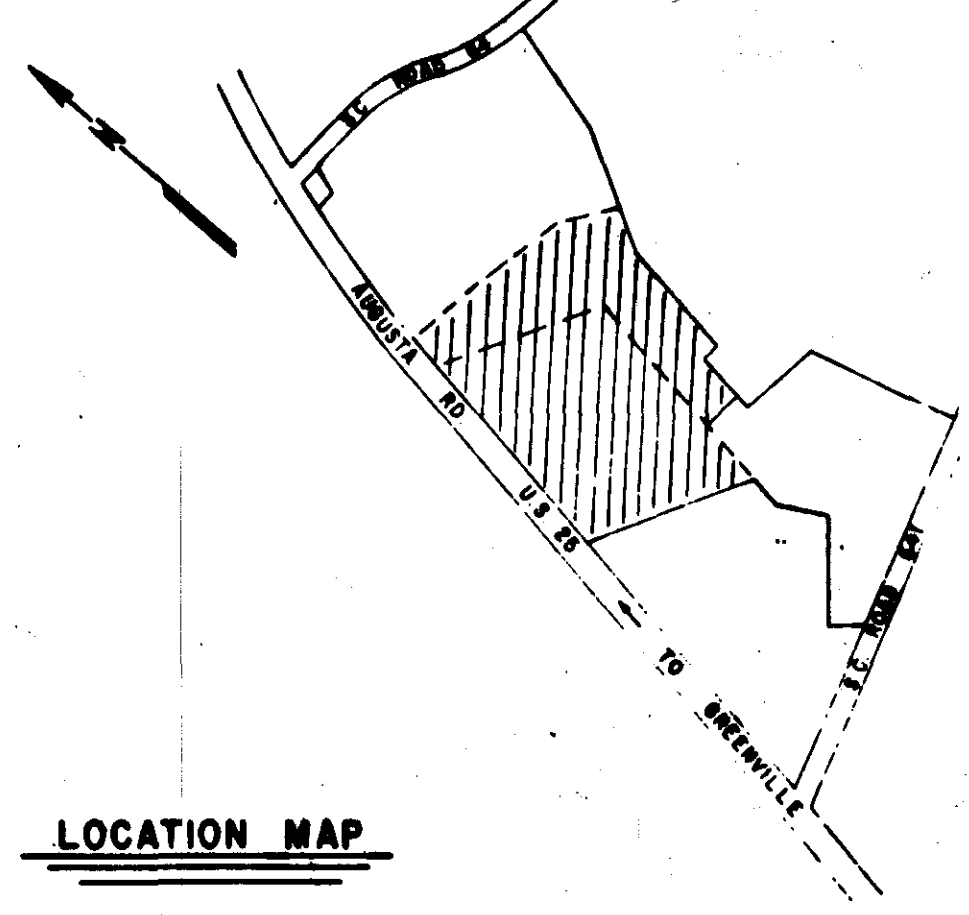


SCALE 1" = 100' MAGNETIC

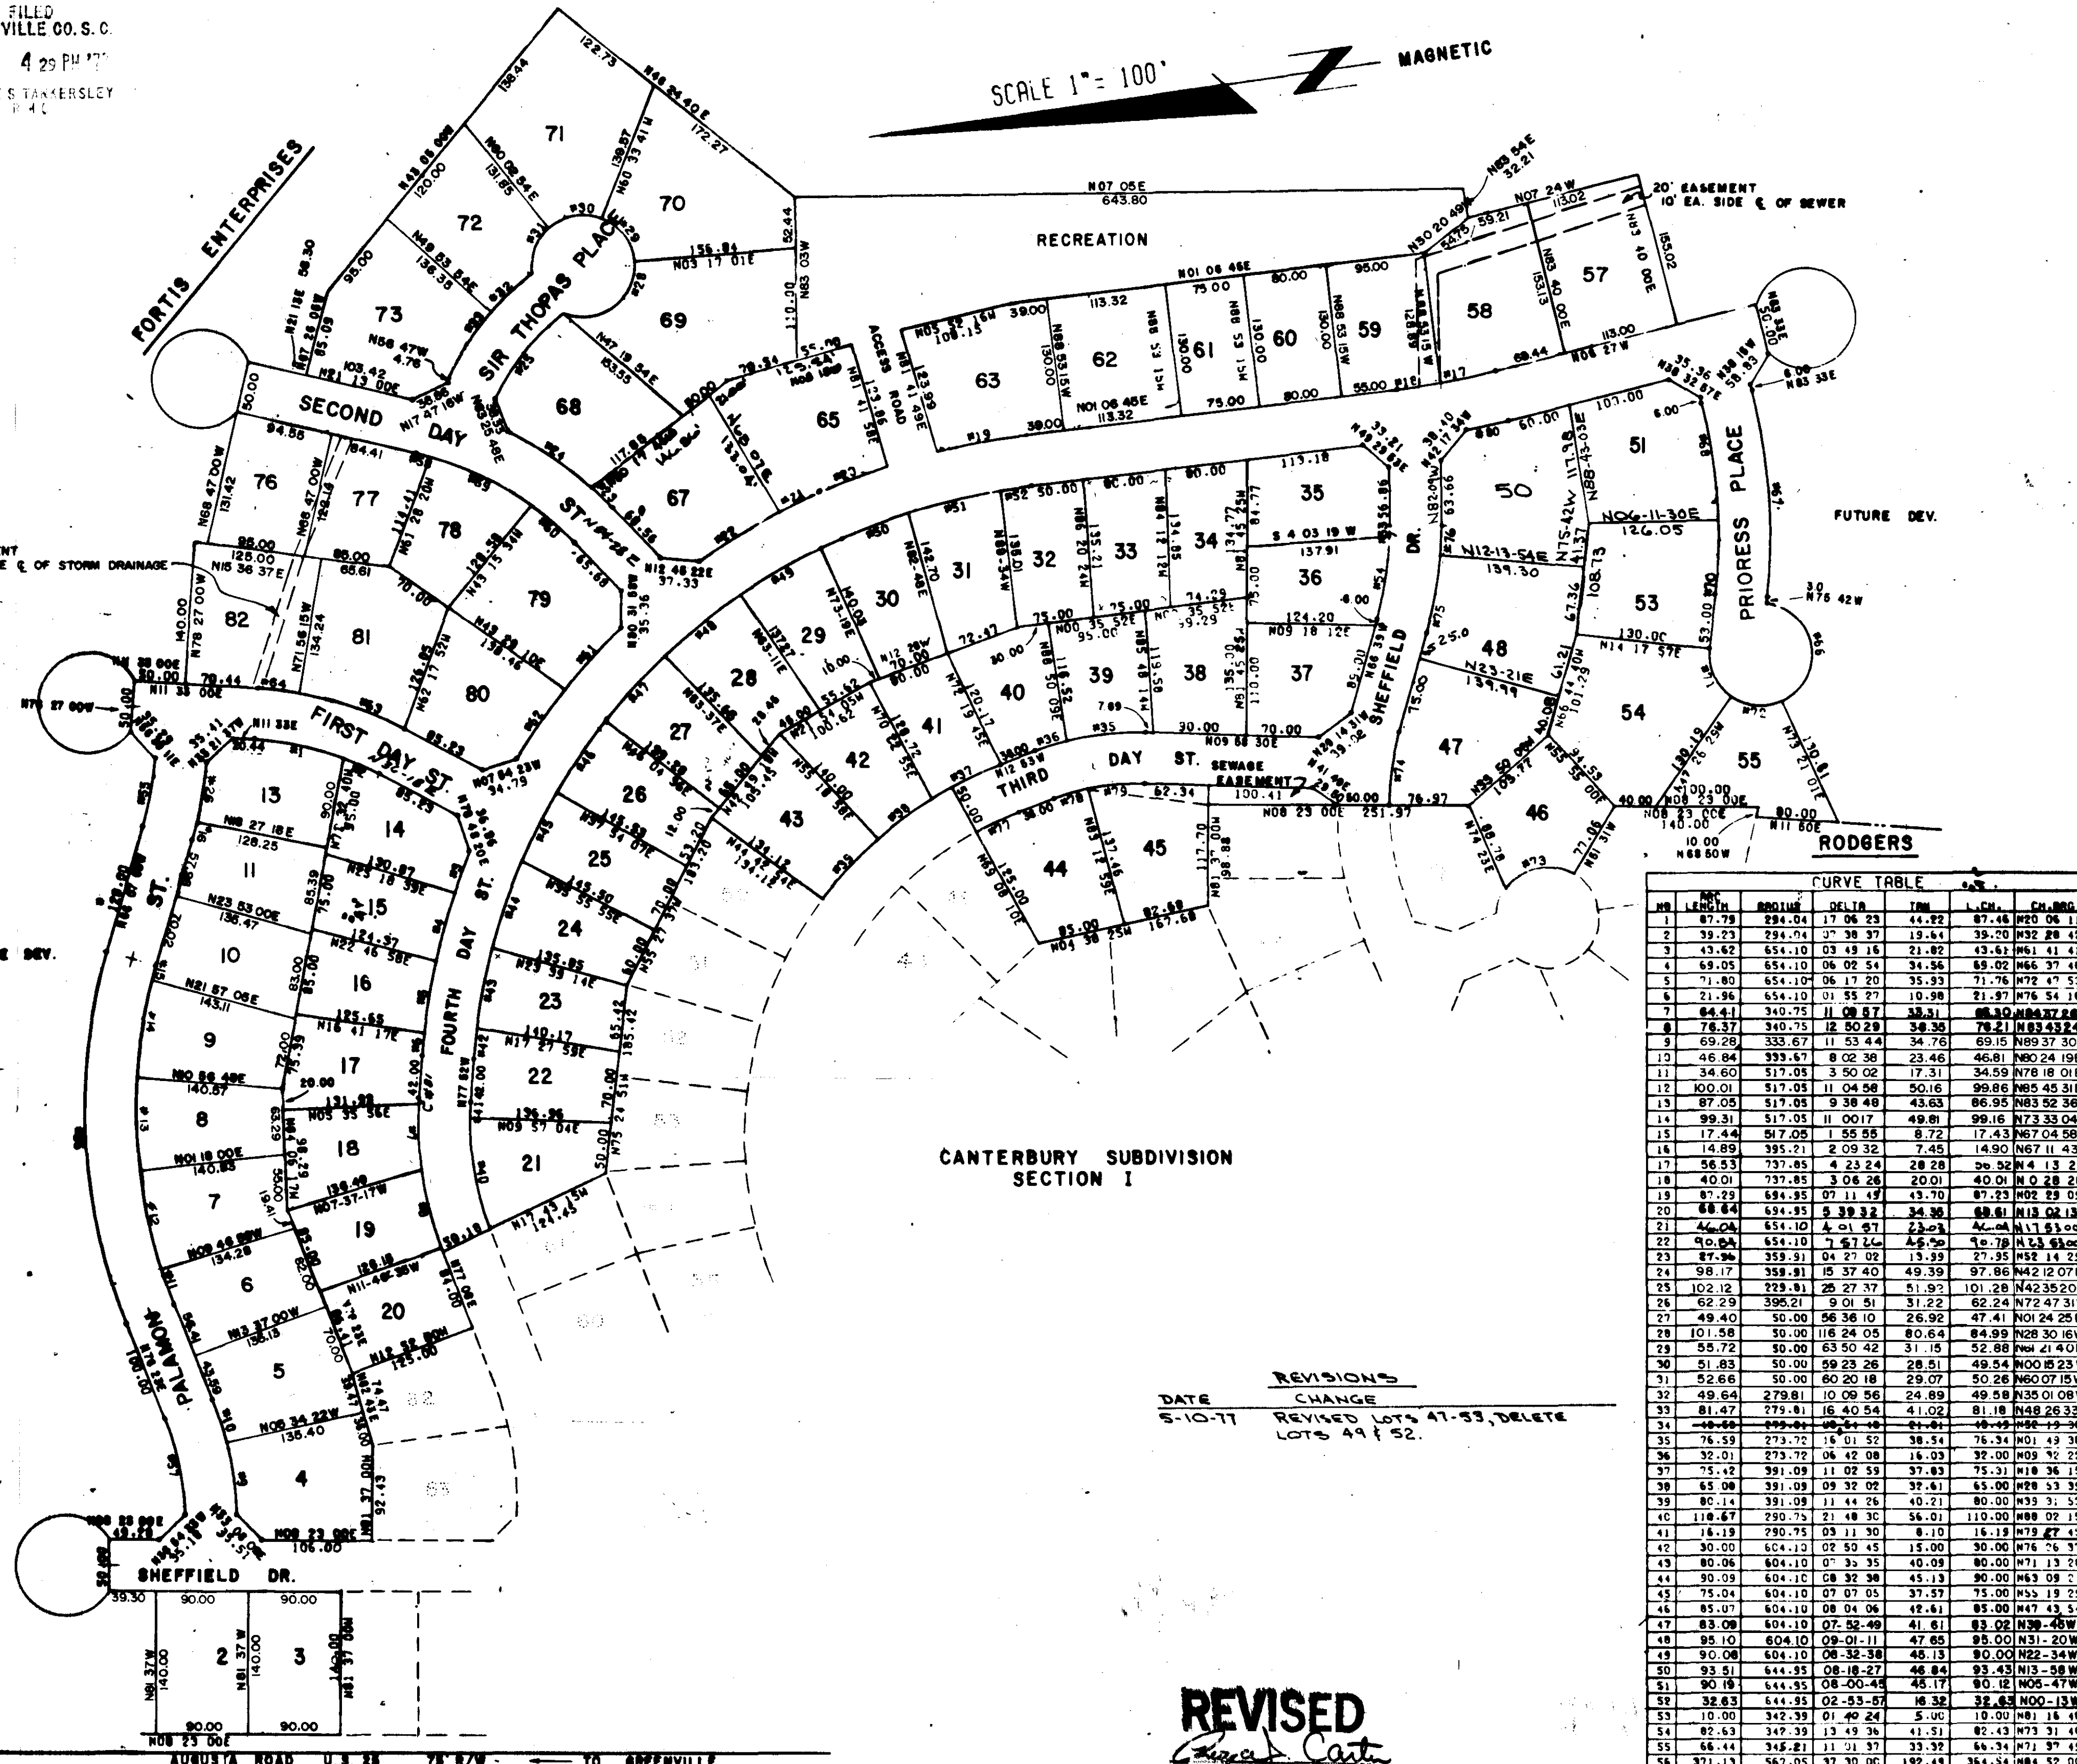

**FINAL PLAT**  
CERTIFICATE OF OWNERSHIP AND DEDICATION

"The undersigned hereby acknowledge that I am (we are) the owner(s) of the property shown and described hereon and that I (we) hereby adopt this plan of subdivision with my (our) free consent and that I (we) establish the minimum building restriction lines, and hereby dedicate to public use as roads, streets, and easements, all areas so shown or indicated on said plat.

9/12/77 Signed \_\_\_\_\_  
9/25/77 Signed \_\_\_\_\_  
9/12/77 Signed \_\_\_\_\_  
1-1-1 Signed \_\_\_\_\_

**CERTIFICATE OF ACCURACY**

"I, W. L. HEANER, JR., certify that this plat was (drawn-by-me) (drawn under my supervision) (an actual survey made under my supervision) from (an actual survey made-by-me) (deed description recorded in Book \_\_\_\_\_ Page \_\_\_\_\_ Book \_\_\_\_\_ Page \_\_\_\_\_, etc.) (other); that the error of closure as calculated by latitude and departure is 1:3000; that the boundaries not surveyed are shown as broken lines plotted from information found in Book \_\_\_\_\_ Page \_\_\_\_\_; that this plat was prepared in accordance with the Greenville County Subdivision Regulations as adopted.

Sept. 15, 1977 DATE  
W. L. Heaner, Jr. LICENSED ENGINEER OR REGISTERED SURVEYOR

S. C. Registration No. 2559

**CERTIFICATE OF APPROVAL FOR RECORDING**

"I hereby certify that the subdivision plat shown hereon has been found to comply with the Subdivision Regulations for Greenville County, with the exception of such variances, if any, as are noted in the minutes of the Greenville County Planning Commission of Greenville County, South Carolina, and that it has been approved for recording in the office of the County Register of Mense Conveyance."

9/19/77 DATE  
Raymond J. Carter DIRECTOR OF PLANNING  
GREENVILLE COUNTY PLANNING COMMISSION

**FILE NUMBER**  
# 72-149

**CANTERBURY SUBD. SECTION II**

FORTIS ENTERPRISES GREENVILLE, S. C. HEANER ENGR. CO. INC. GREENWOOD, S. C.

NO. OF ACRES 29.2 MILES OF NEW ROAD 0.95  
NO. OF LOTS 85 DATE 7/17/72 REVISION 9/28/72  
