
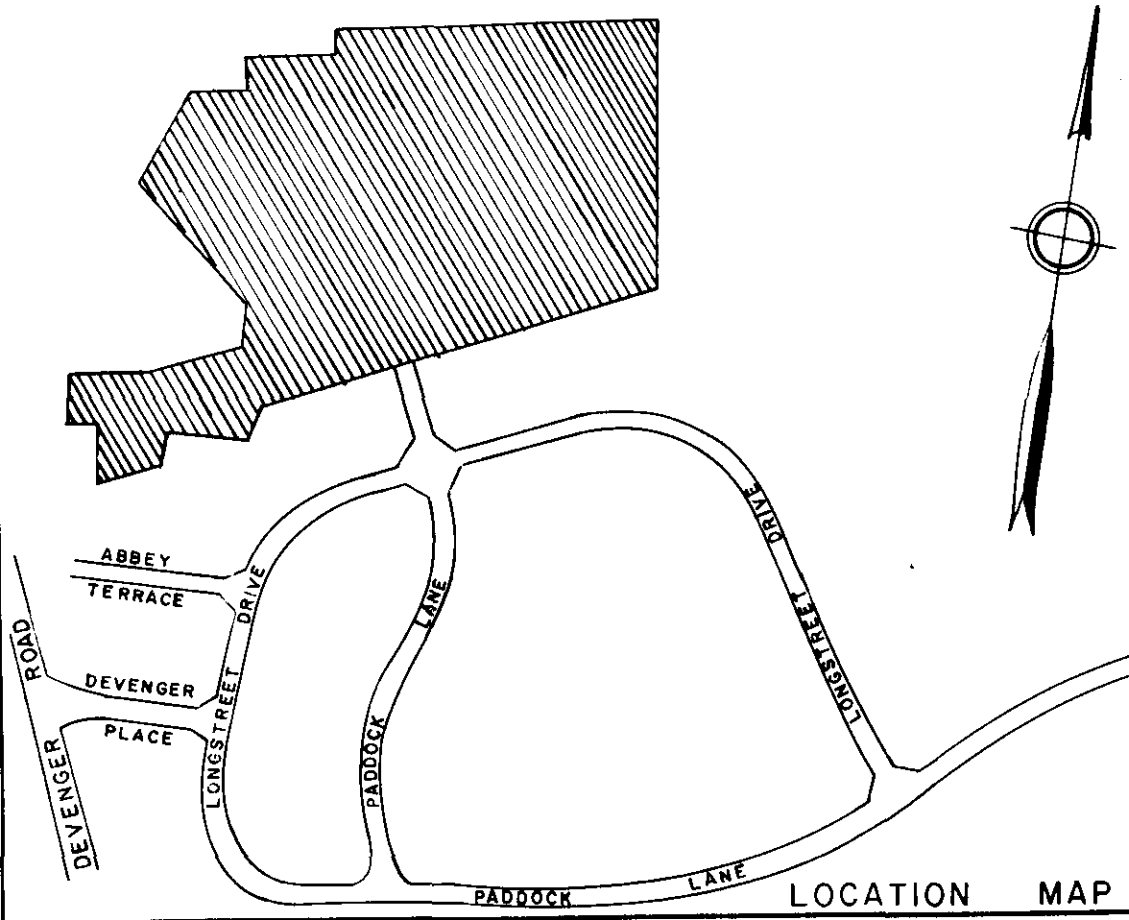


Wm. R. CELY JR.

DEVENGER ROAD LAND CO.

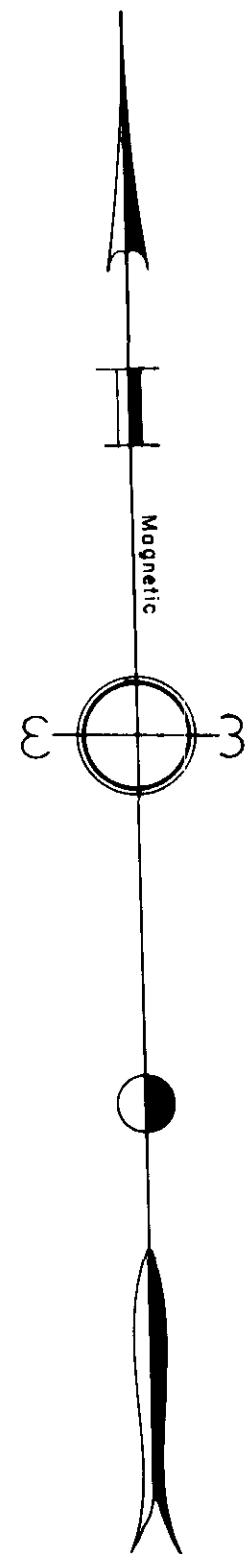

FINAL PLAT

CERTIFICATE OF OWNERSHIP AND DEDICATION

"The undersigned hereby acknowledge that I am (we are) the owner(s) of the property shown and described hereon and that I (we) hereby adopt this plan of subdivision with my (our) free consent and that I (we) establish the minimum building restriction lines, and hereby dedicate to public use as roads, streets, and easements, forever all areas so shown or indicated on said plat.

7 / 26 / 1977 Signed Wm. R. Cely Jr.
 / / / Signed _____
 / / / Signed _____
 / / / Signed _____

CERTIFICATE OF ACCURACY

"I, William B. Font, certify that this plat was (drawn by me) (drawn under my supervision) (an actual survey made under my supervision) from (an actual survey made by me) (dead description recorded in Book _____ Page _____ Book _____ Page _____, etc.) (other); that the error of closure as calculated by latitudes and departures is _____ that the boundaries not surveyed are shown as broken lines plotted from information found in Book _____ Page _____; that this plat was prepared in accordance with the Greenville County Subdivision Regulations as adopted.

July 26, 1977 DATE William B. Font LICENSED ENGINEER OR REGISTERED SURVEYOR
 S. C. Registration No. _____ 6266

CERTIFICATE OF APPROVAL FOR RECORDING

"I hereby certify that the subdivision plat shown hereon has been found to comply with the Subdivision Regulations for Greenville County, with the exception of such variances, if any, as are noted in the minutes of the Greenville County Planning Commission of Greenville County, South Carolina, and that it has been approved for recording in the office of the County Register of Mass Conveyance."

Aug 26 1977 DATE Rayce J. Carter DIRECTOR OF PLANNING GREENVILLE COUNTY PLANNING COMMISSION

77-130
FILE NUMBER
 REVISED

SECTION NO. 4
DEVENGER PLACE

DEVENGER ROAD LAND CO. DALTON & NEVES CO.
 OWNER ENGINEERS

NO. OF ACRES 17.90 MILES OF NEW ROADS 0.44

NO. OF LOTS 29 DATE July, 1977

ZONED R-12

SCALE 1" = 100'

100 0 100 200

5' Drainage & Utility Easement along all rear & side lot lines.
 Iron pins at all corners.

Revision of Lot 123 Feb. 1978

PAC 2/14/78

Plat Filed This 24 day of Feb, 1978
 And Recorded in Vol. 64 Page 29 at 4:01 P.M.
Dianne S. Tankersley
 Register Mass Conveyance Greenville County, S. C.

6-H-24

25049