

- 1. Composite plat made from plats furnished by owner.
- 2. Sections one & two, no field work done by Heaner Engineering Company.
- 3. Revision of sewer easement across lots 18 & 19 in Section II.
- 4. Lots 24 thru 28 added to Section III.
- 5. 5' Utility & Drainage Easement along each side of side & rear lot lines in addition to easements shown on Plat.


Rev.: Dec 20, 1978 - Changed viance only

NOTE:

NAME CHANGE THE

19795

16-H-89

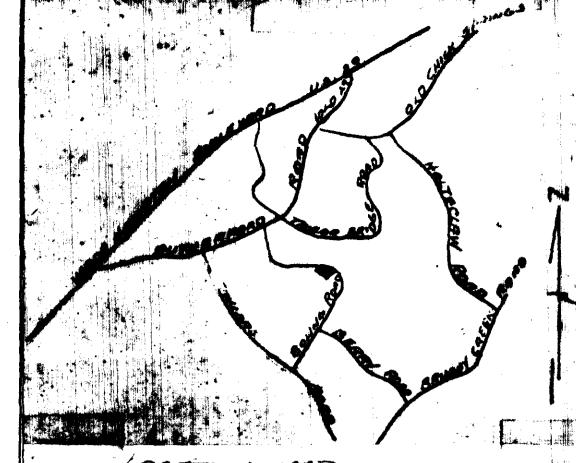

LOCATION MAP

# FINAL PLAT

### CERTIFICATE OF OWNERSHIP AND DEDICATION

consent and that I (we) establish the minimum building restriction lines, and hereby dedicate to public use as roads, streets, and easements, forever, all areas so shown or indicated on said plat.

G-127178	Signed Howald Company
//	Signed
	Signed
//	Signed

#### CERTIFICATE OF ACCURACY

RE BLACKMORE, certify that this plat was (drawn by me) (drawn by me) (deed description recorded in Book Page , etc.) (other); that the error of closure as calculated by latitudes and departures is 1:3000 , that the boundaries not surveyed are shown as broken lines platted from information found in Book\_\_\_\_\_\_, Page\_\_\_\_\_

1AR. 15 1974	Konald & Blackman
DATE	LICENSED ENGINEER OF REGISTERED SURVEYO

S. C. Registration No. 5291

## CERTIFICATE OF APPROVAL FOR RECORDING

# FILE NUMBER

74-108

CHIPENDALE FOREST

THE WASTERLO	HEANER ENGR CO TIME SURVEYOR
-	

NO. OF ACRES: /9-6

MILES 0.32

NO. OF LOTS: ゴイ

DATE: 3/15/74

SCALE: