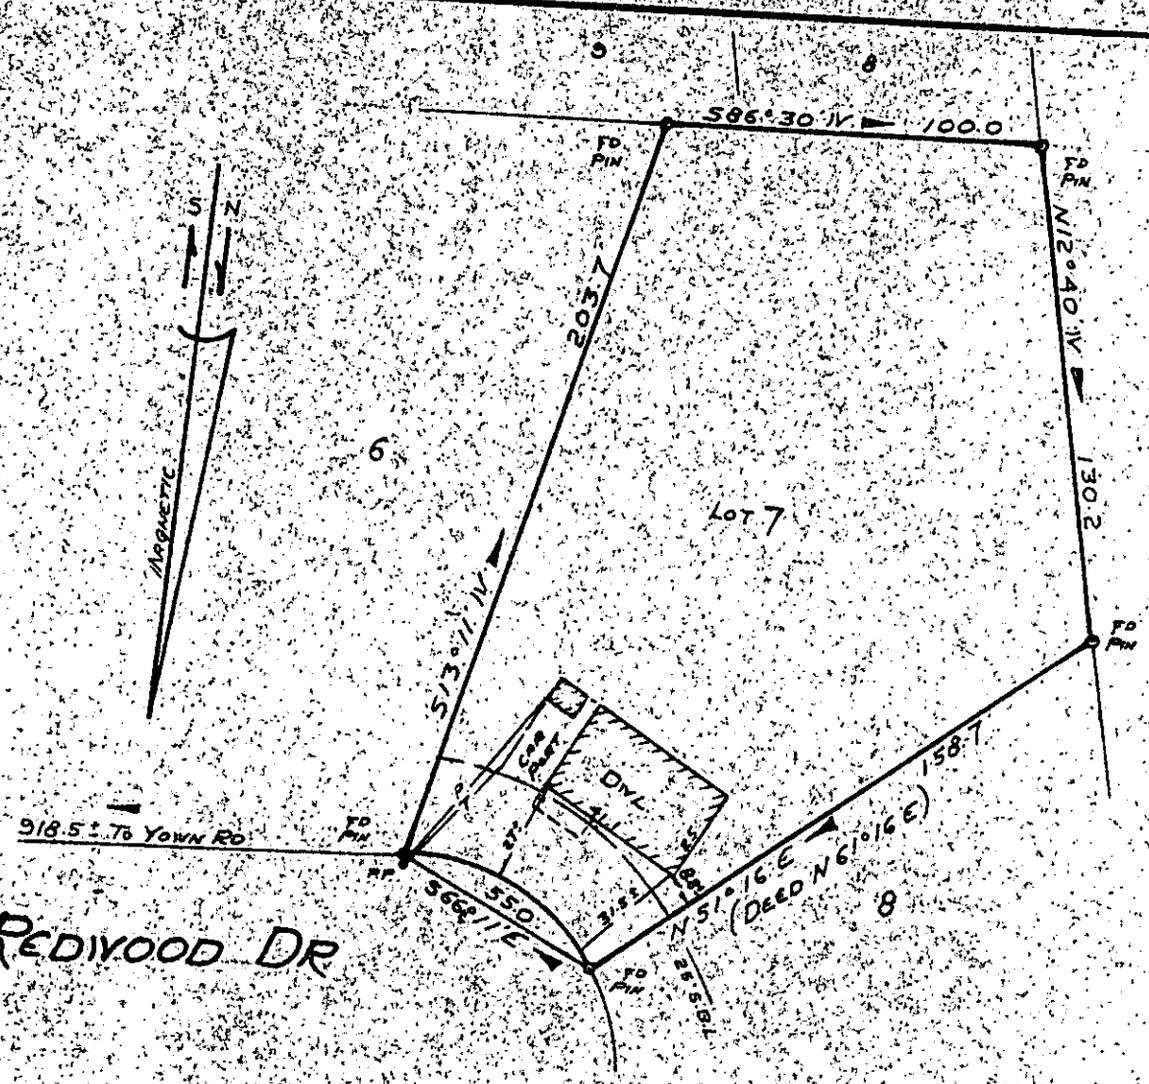

PROPERTY OF
RUSSELL A. PRYOR
AND
TERESA R. PRYOR

NEAR GREENVILLE, SOUTH CAROLINA
SCALE 1" = 50' SEPT 9, 1977

9531

FILED
GREENVILLE CO. S.C.
SEP 23 2 13 PM '77
DONNIE S. TANKERSLEY
R.M.C.

This is to certify that on September 9, 1977, I surveyed the property shown on this plat, known as Lot No. 7 of Subdivision No. 1. Property of W. H. Hendrix as shown on a plat recorded in the RMC Office for Greenville County in Plat Book HH at page 31, and that the property lines, walls and building are as shown hereon, and that the building located on said lot does not project nor encroach on adjacent streets or property, and that no adjacent walls or buildings project nor encroach on said lot, and that no utility lines cross this lot except as may be shown hereon.

NOTE: This property is not located within a flood hazard area.

Survey by: Richard Wooten Land Surveying Co.

Richard D. Wooten, Jr.
S. C. R. L. S. No. 6878

4 8 4 K SEP. 23 E

1.00 A1

V6-I-26

MICROFILMED

SEP 23 '77