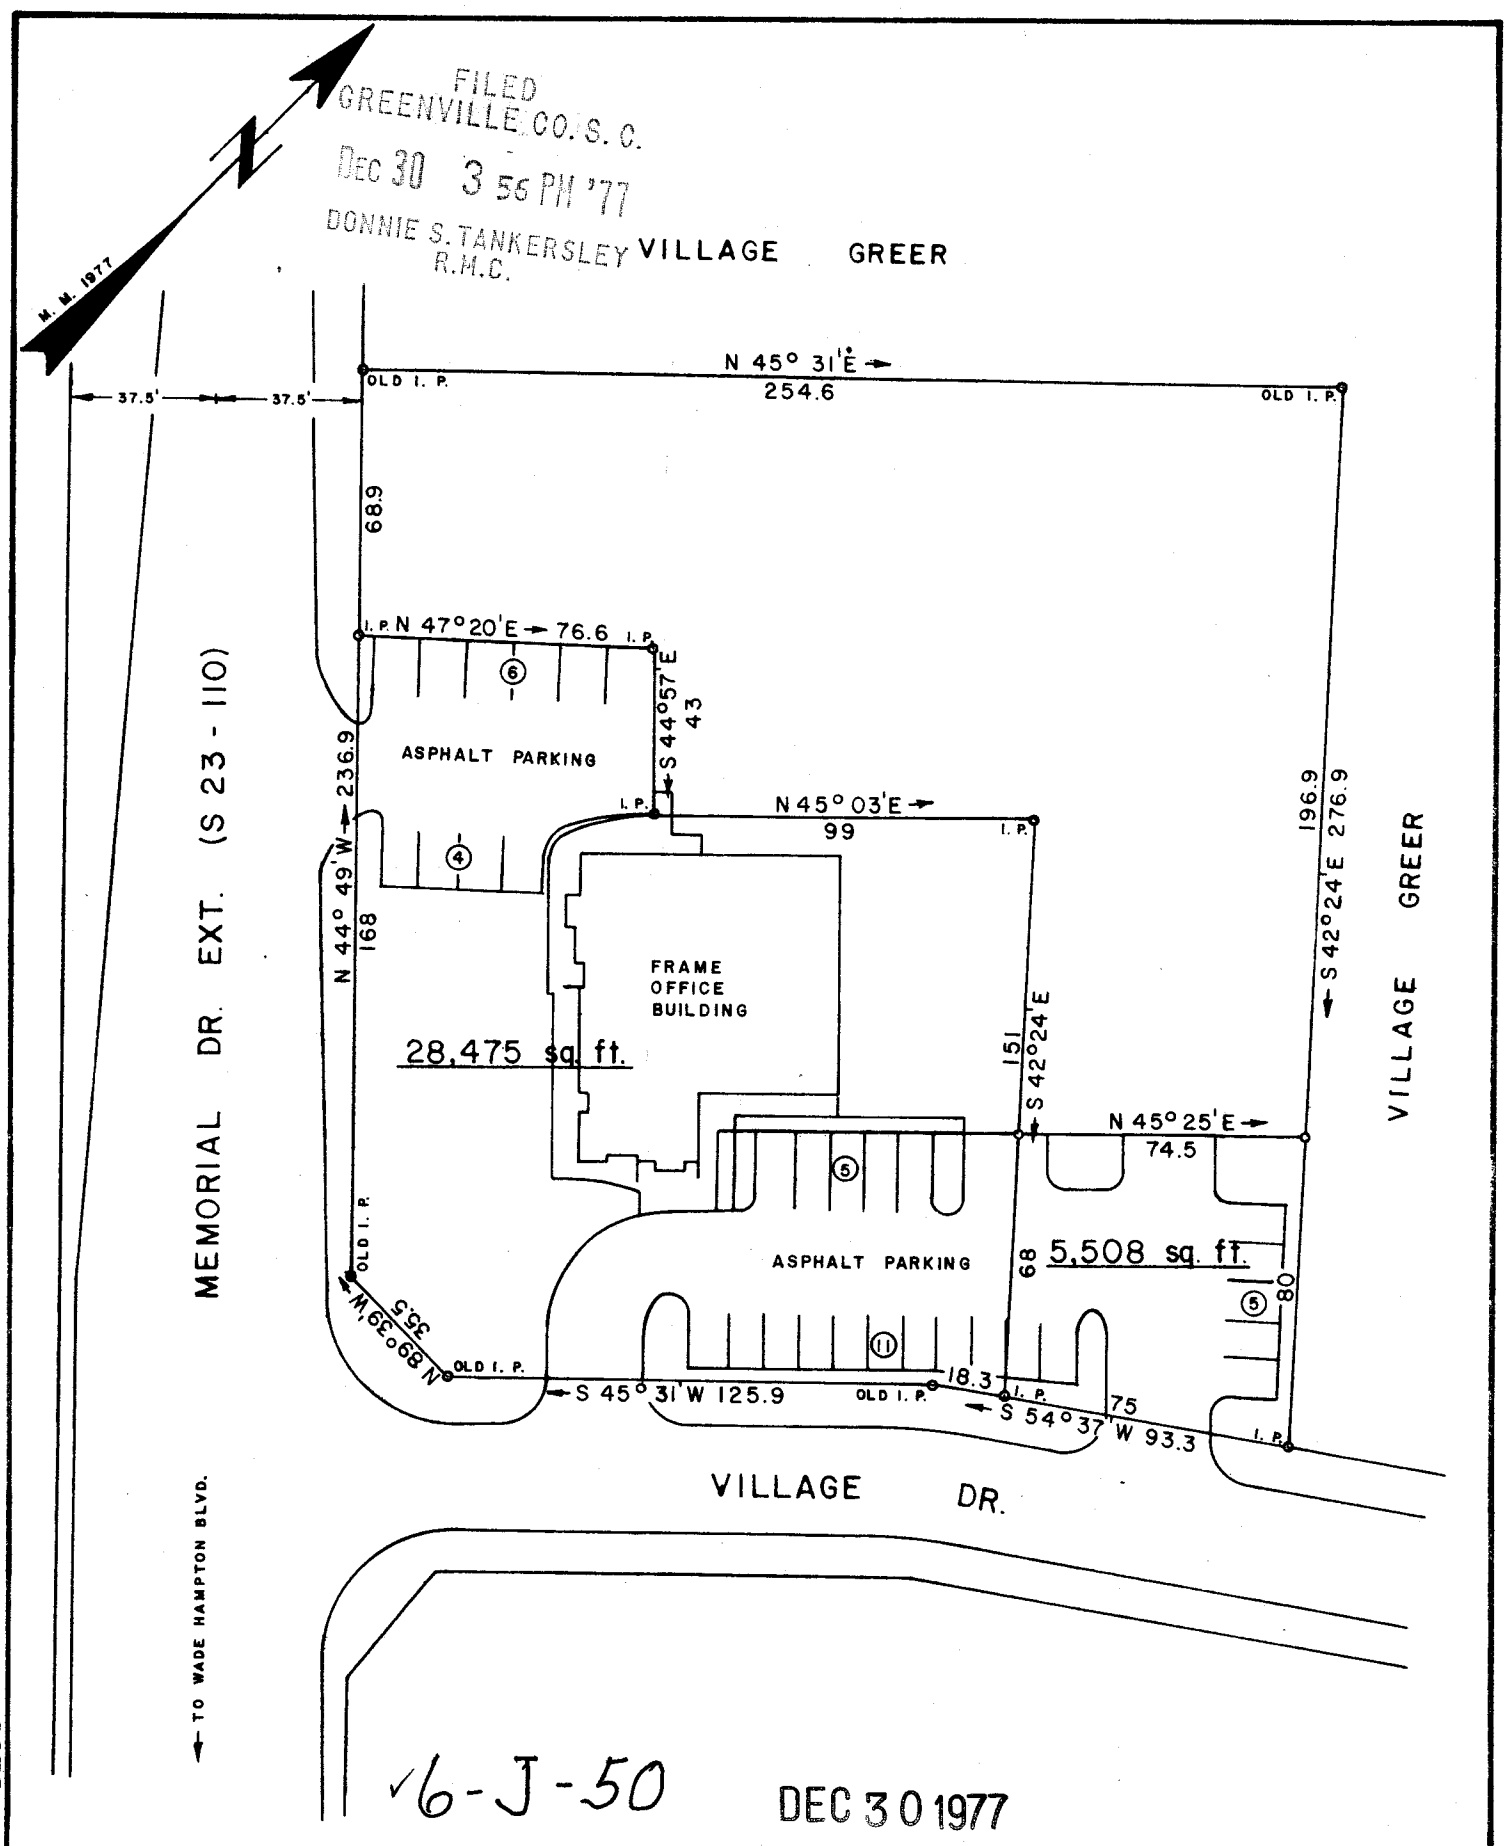

REF. TO PLAT FOR JOHN E. WALTON BY JOHN A. SIMMONS, DATED MAY 19, 1976.

THIS IS TO CERTIFY THAT ON THIS DATE I SURVEYED THE PROPERTY SHOWN HEREON AND THE LINES ARE AS SHOWN, THAT THE BUILDING(S) OR WALL(S) DO NOT ENCROACH ON THE ADJOINING PROPERTY, AND THAT THE BUILDING(S) OR WALL(S) OF THE ADJACENT PROPERTY DO NOT ENCROACH EXCEPT AS SHOWN. I CERTIFY THAT THIS PROPERTY ~~(IS)~~ (IS NOT) IN ANY FLOOD AREA. AND THAT NO UTILITY RIGHT-OF-WAY OR UTILITY ENCROACH ON THIS PROPERTY.

B. E. Huskey

SURVEY FOR

JOHN E. WALTON 19742

LOCATED IN GREER

COUNTY: GREENVILLE	COUNTY BLOCK MAP:	STATE: SOUTH CAROLINA	
DATE: NOVEMBER 15, 1977	SCALE 1" = 50'	FIELD CHEIF: B. E. H.	DRAWN BY: L. B. M.

WOLFE & HUSKEY, INC. ENGINEERING and SURVEYING
P. O. BOX 35 LYMAN, S. C. 29365

EDWARD EUGENE HUSKEY REG. 4786 LICENSED SURVEYOR SOUTH CAROLINA

B. E. Huskey

MICROFILMED

GCTO --- 1 DE30 77 621 2.00

77-14-33

A 1