BLOCK BOOK REF:
196 - 2 - 15

NOTE:
IMPROVEMENTS ON THIS TRACT ARE NOT IN A FLOOD HAZARD AREA.

FILED
GREENVILLE CO. S. C.
FEB 28 12 36 PM '78
DONNIE S. TANKERSLEY
R.M.C.

MICROFILMED

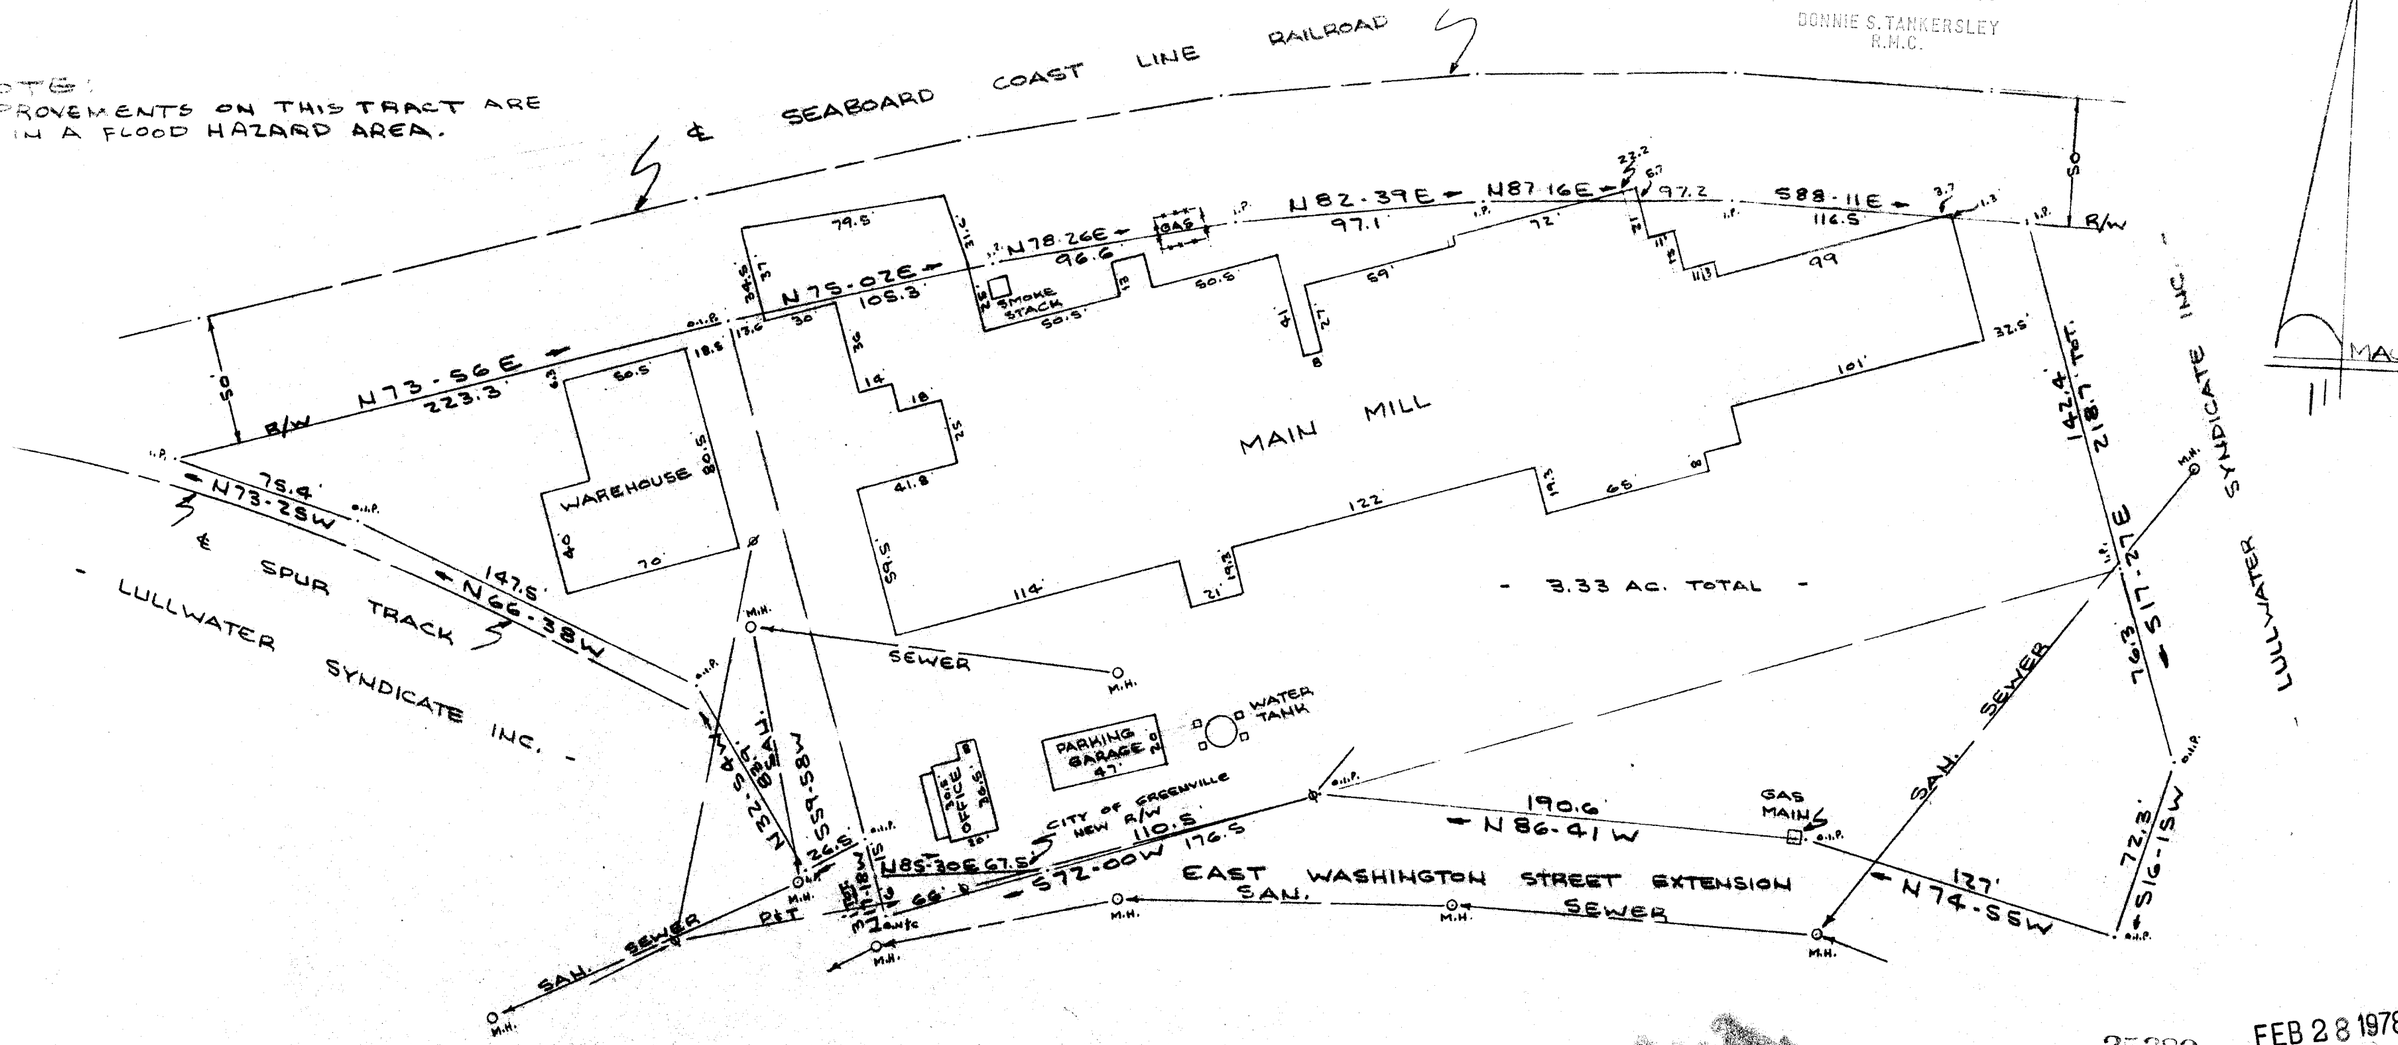


SURVEY FOR
WESTBORO CORPORATION
GREENVILLE, SOUTH CAROLINA
SCALE: 1"=50' 24 FEB 1978

CAROLINA SURVEYING CO.
112 MANLY ST.
GREENVILLE, S. C.

R. B. Bruce #1952

SOUTH CAROLINA REGISTERED NO. 1052 LAND SURVEYOR

R.B. Bruce #1952

25389 FEB 28 1978

6J-86

GCTO -----3 FE28 78 951 2.00CI

203/C-7

196 - 2 - 15