


POINSETT HIGHWAY

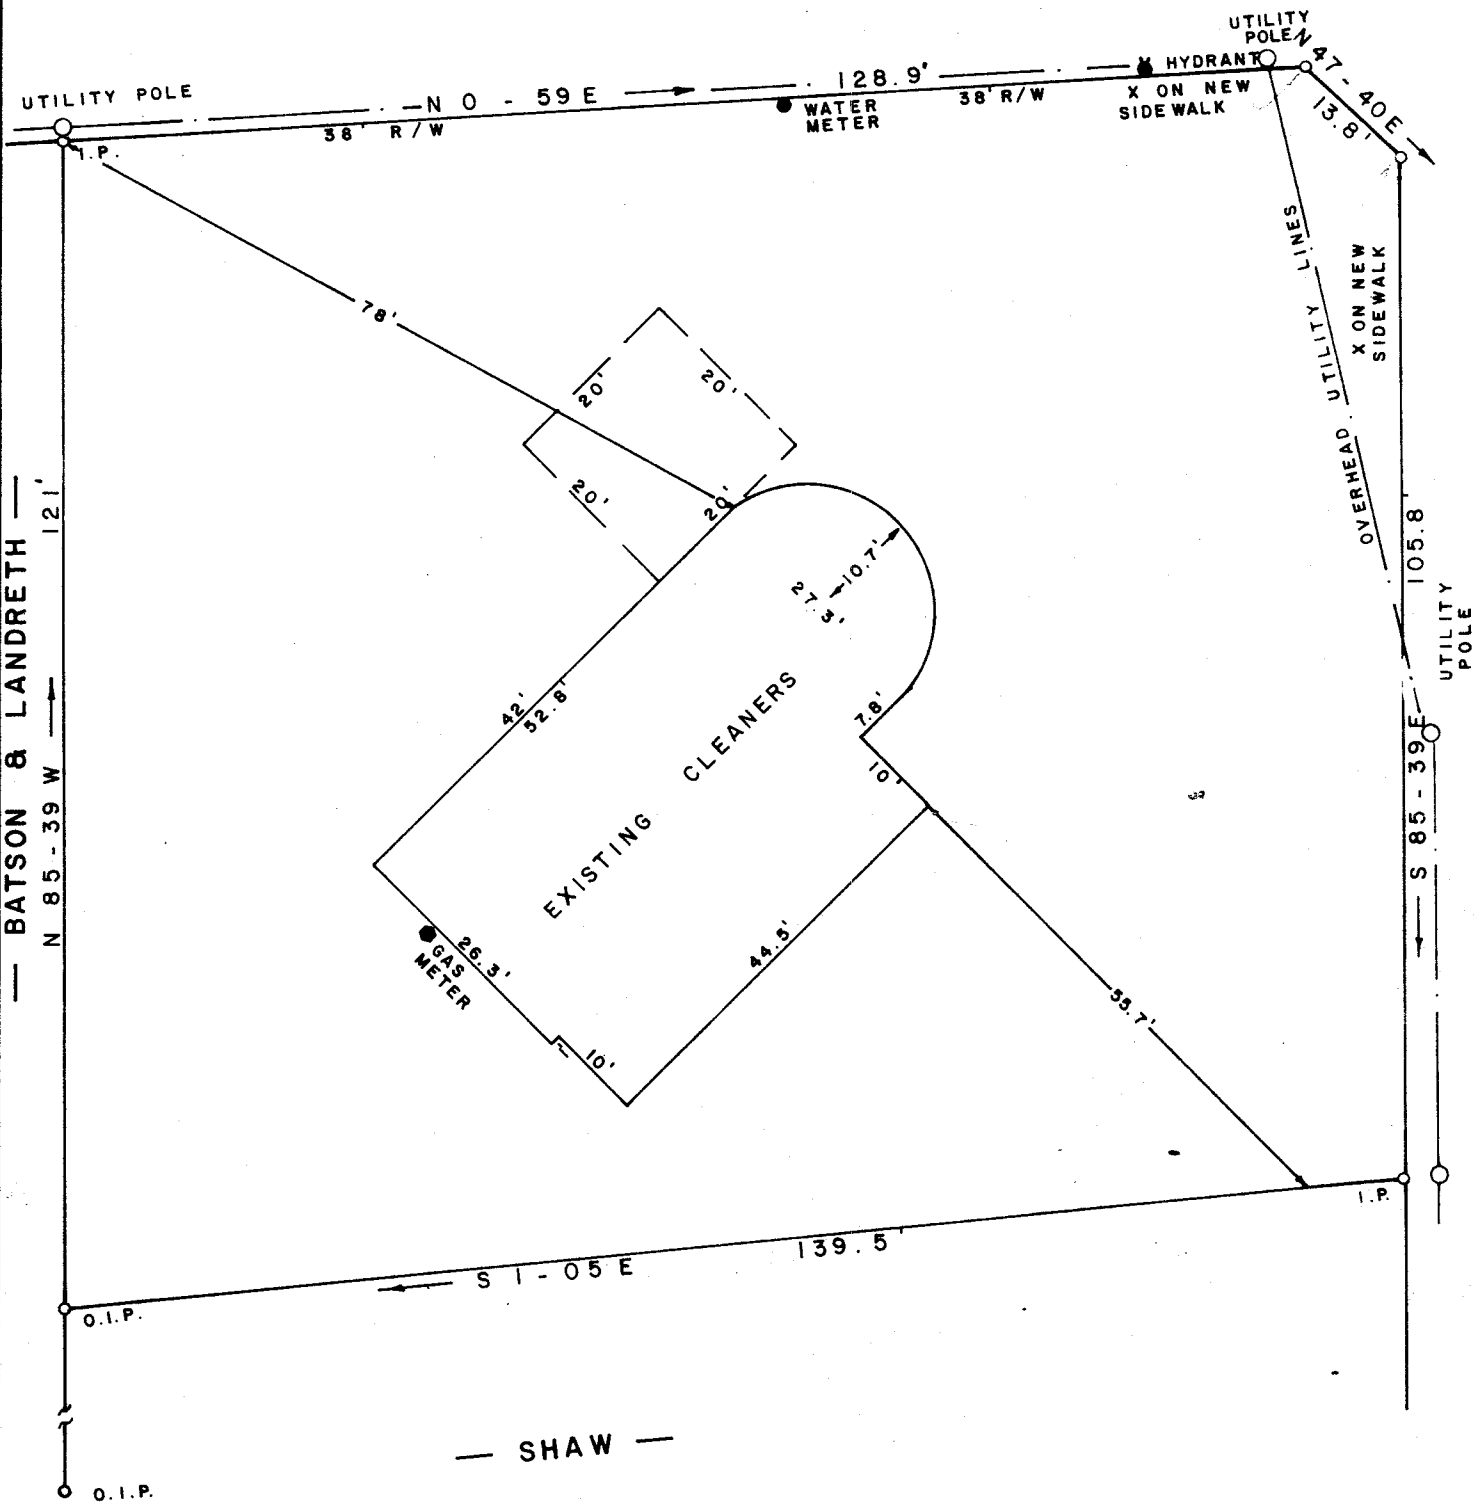

STREET

77ANDAN

FILED  
 GREENVILLE, S. C.  
 MAR 27 12 36 PM '78  
 DONNIE S. TANKERSLEY  
 R.M.C.

PROPERTY OF  
**ONE HOUR CLEANERS OF SPARTANBURG, INC.**  
 CITY OF GREENVILLE  
 SOUTH CAROLINA  
 FEBRUARY 16, 1978

*W. R. Williams*  
 SOUTH CAROLINA  
 REGIS. PROFESSIONAL  
 LAND SURVEYOR  
 W. R. WILLIAMS, JR. ENGR. / SURVEYOR # 3979  
 15 SOUTH MAIN STREET  
 TRAVELERS REST, S. C. **MICROFILMED**

28351

✓ 16-J-96