


This is to certify that on October 10, 1977, I surveyed the property shown on this plat known as property Bob Maxwell Builders, Inc., recorded in the RMC Office of Greenville County in Deed Book 896 on Page 72, and that the property lines, walls, and buildings are as shown hereon; that the building located on said lot does not encroach or project on adjacent streets or property, and that no adjacent walls or buildings encroach or project on said premises and that no utility lines cross this property except as shown hereon.

*James R. Freeland*  
 James R. Freeland RLS & PE 4781

This property is not located in a flood hazard area.

FILED  
 GREENVILLE CO. S.C.  
 OCT 20 4 15 PM '77  
 DOCUMENT RECORDED BY  
 R.H.C.

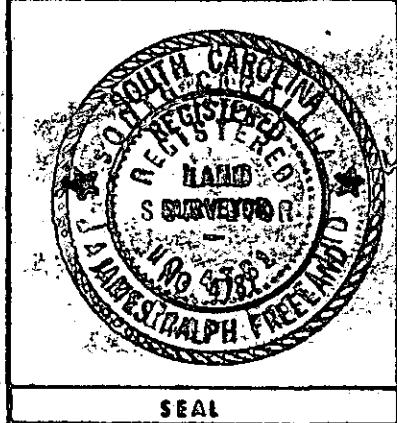

STATE OF SOUTH CAROLINA  
 GREENVILLE COUNTY  
 6K-4 PROPERTY OF  
 DAVID M. WILSON  
 TAMMY S. WILSON  
 8097 ST 280 100.44

FREELAND & ASSOCIATES  
 Engineers • Land Surveyors  
 GREENVILLE, S. C.  
 SURVEY JRF  
 DRAWN JRF  
 CHECK M.C.  
 SCALE 1"=50'  
 DATE 10-10-77  
 DWO. NO. 77-1801