


FILED
GREENVILLE CO. S.C.
NOV 14 4 30 PM '77
DONNIE S. TANKERSLEY
R.M.C.

FARMINGTON ROAD
WATER & SEWER IN ST. RIW

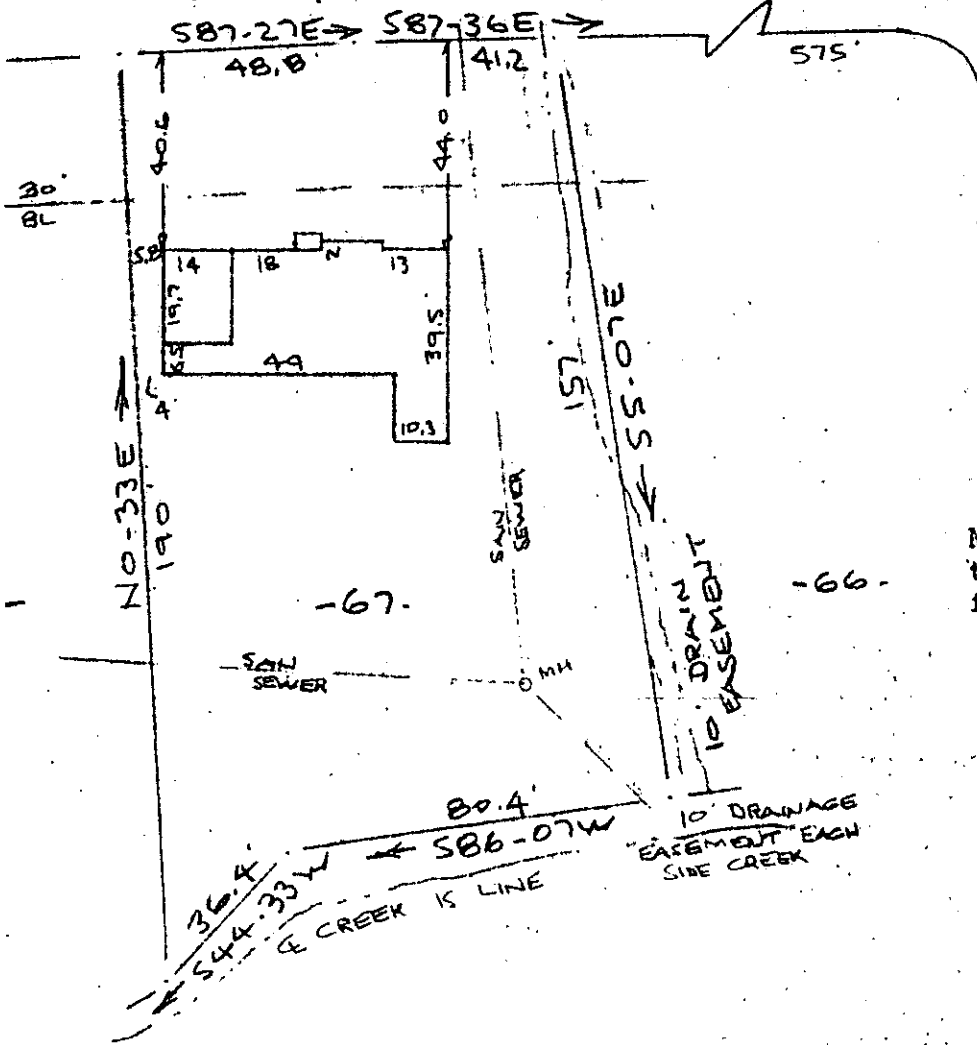

NOTE: Improvements on this lot are not in a flood hazard area.

PROPERTY OF
MANSOUR EMTIAZ & BRENDA B. EMTIAZ
NEAR GREENVILLE, S. C.
SCALE: 1"=40' NOV 1977

This is to certify that on the 1st day of November, 1977, I surveyed the property shown on this plat, being known as lot 67 on plat of CHESTNUT HILLS and recorded in the RMC Office Greenville County, S. C., in Plat Book "QQ" at Page 83; and that the property lines, walls and buildings are as shown hereon, and that the walls and buildings located on said lot do not encroach or project on adjacent street or property, and that no adjacent walls or buildings encroach or project on said premises, and no power lines cross this property except as shown hereon.

R. B. Bruce
R. B. Bruce, RLS #1952

14955

✓6-K-31

CAROLINA SURVEYING CO.
112 Manly St.
Greenville, S. C.

NOV 14 1977

MICROFILMED

GCTO ---1 NO14 77 192

1.00CI

123/4