


THIS PLAT FOR RECORDING

FILED
GREENVILLE CO. S. C.
NOV 23 3:46 PM '77
DONNIE S. TANKERSLEY
R.M.C.

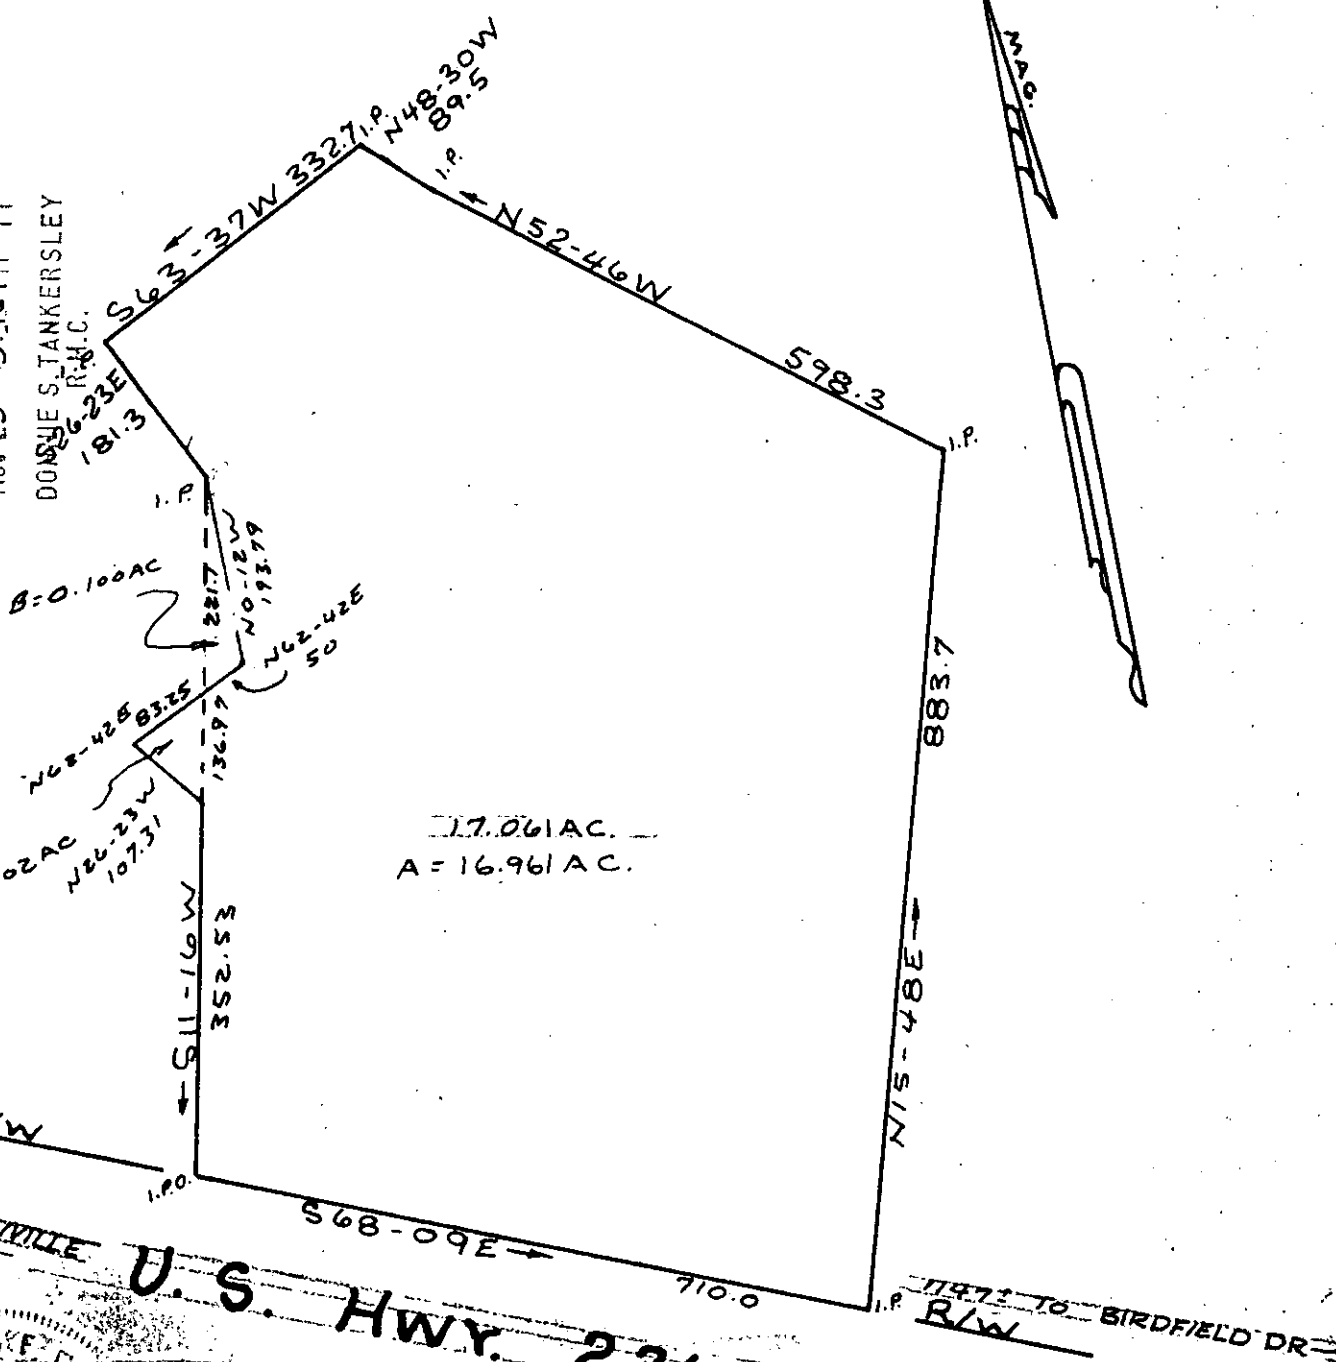

PLAT FOR
JOHN D. HOLLINGSWORTH JR.

NEAR THE CITY OF GREENVILLE
GREENVILLE COUNTY S.C.

WEBB SURVEYING & MAPPING CO.
SCALE 1" = 266.70' = 1000' / 3.75
NOV 23 1977 834#

16K-49
NOV 23 1977
16135 1.00CI

REVISED NOV. 1977

MICROFILMED