


MAG. NOV 25 4 26 PM '77

DONNIE S. TANKERSLEY R.M.C.

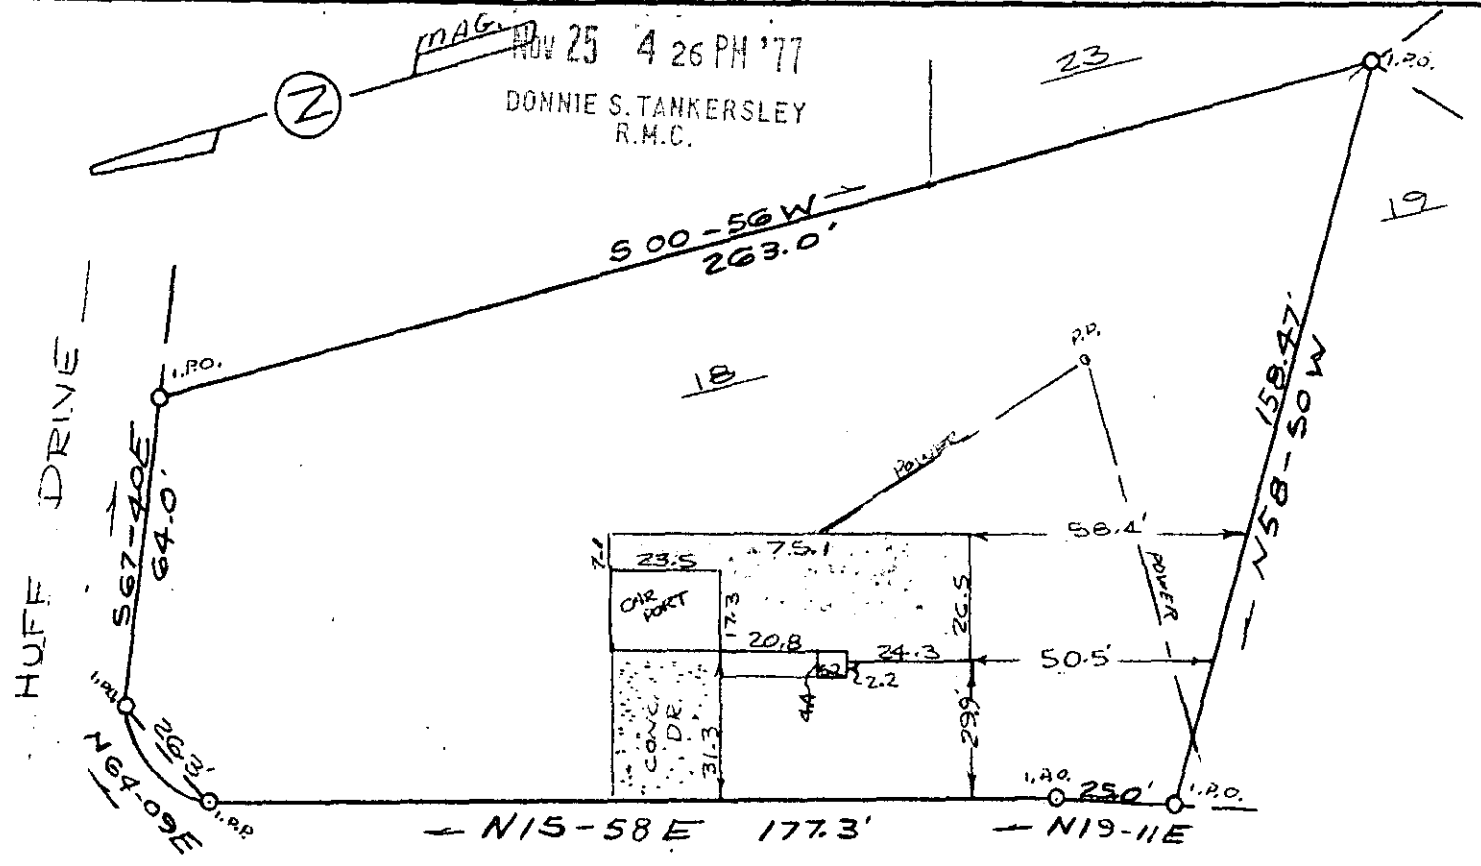

VICKILYN COURT

This is to certify that on November 3, 1977, I surveyed the property shown on this plat, known as Lot 18 on Revised Plat of Staunton Heights, recorded in the RMC Office of Greenville County in Plat Book 4N on Page 38, and that the property lines, walls and buildings are as shown hereon; that the building located on said lot does not encroach or project on adjacent streets or property, and that no adjacent walls or buildings encroach or project on said premises, and that no utility lines cross this property except as shown hereon.

James R. Freeland

James R. Freeland RLS & PE 4781

This property is not located in a flood hazard area.

16295

NOV 25 '77 ✓ 6K-53

248-2-152



SEAL

STATE OF SOUTH CAROLINA
GREENVILLE COUNTY

STAUNTON HEIGHTS

SEC. 1 - LOT 18

PROPERTY OF

MICHAEL E ALLEN

YOLANDE B. ALLEN

FREELAND & ASSOCIATES
Engineers • Land Surveyors

GREENVILLE, S. C.

SURVEY B. H.

DRAWN M. C.

CHECK MLC

SCALE 1" = 40'

DATE 11-4-77

DWG. NO. 77-0001

MICROFILMED