

FILED  
GREENVILLE CO. S. C.

DEC 1 12 01 PM '77

DONNIE S. TANKERSLEY  
R.M.C.







TINDAL ROAD  
Formerly Parker Road

FRANKLIN ROAD

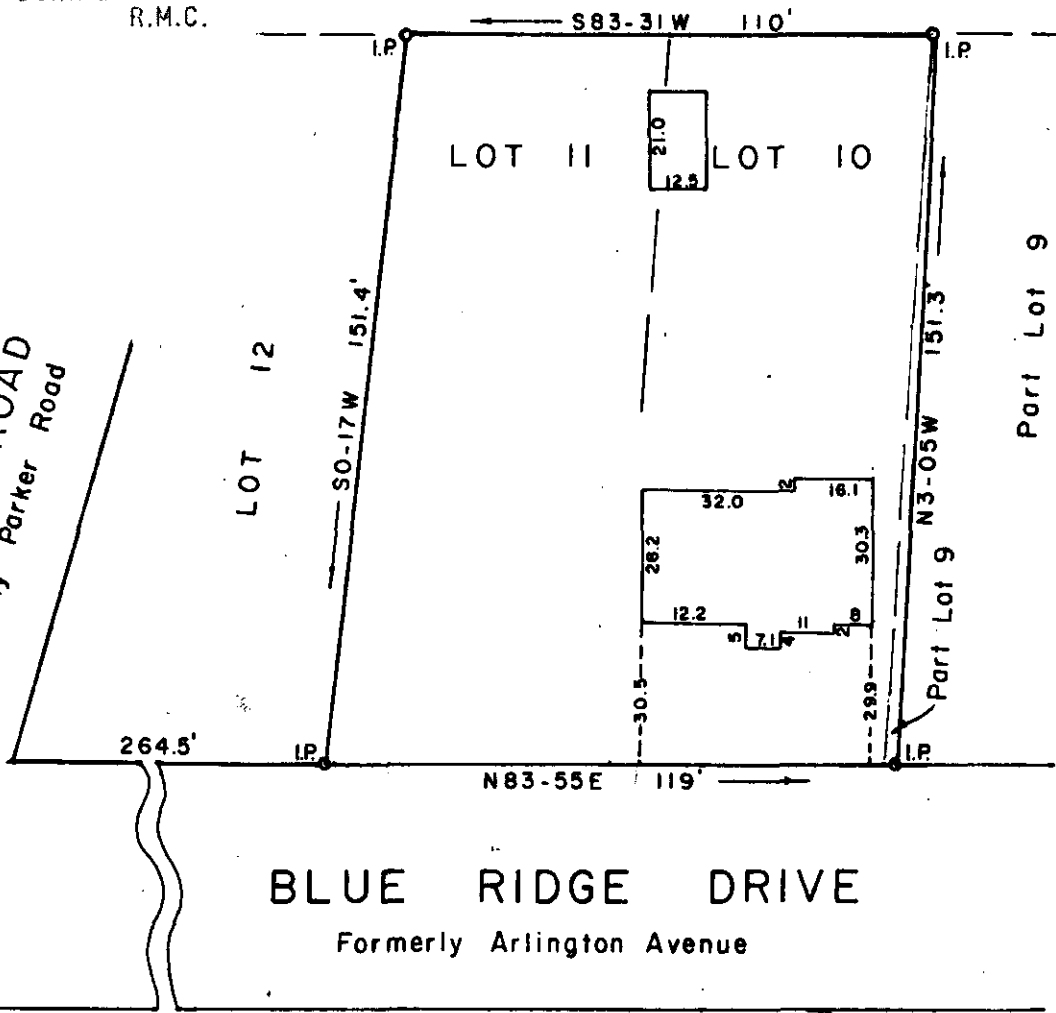

PROPERTY OF

JEROME J. SLOAN

NANCY V. SLOAN

GREENVILLE CO., S. C.

16841

Scale 1" = 40' November, 1977

6K-66

GCTO --- 1 DE 177 1037

This is to certify that on the 21st day of November, 1977, we surveyed the property shown on this plat; being known as part of Lot 9, Lot 10, and Lot 11 on a revised plat property of B. E. Geer recorded in Plat Book G page 253, Office of R.M.C. Greenville Co., S. C.; and that the property lines, walls and buildings are as shown hereon; that the buildings located on said lot do not encroach or project on adjacent streets or property; and that no adjacent buildings or walls encroach or project on said premises; and from information from Greenville County, this structure is not in a designated flood area.

*William B. Fant*  
Dalton & Neves Co., Engineers

F B 389  
S. C. Reg. No. 6266

DEC 1 1977

MICROFILMED