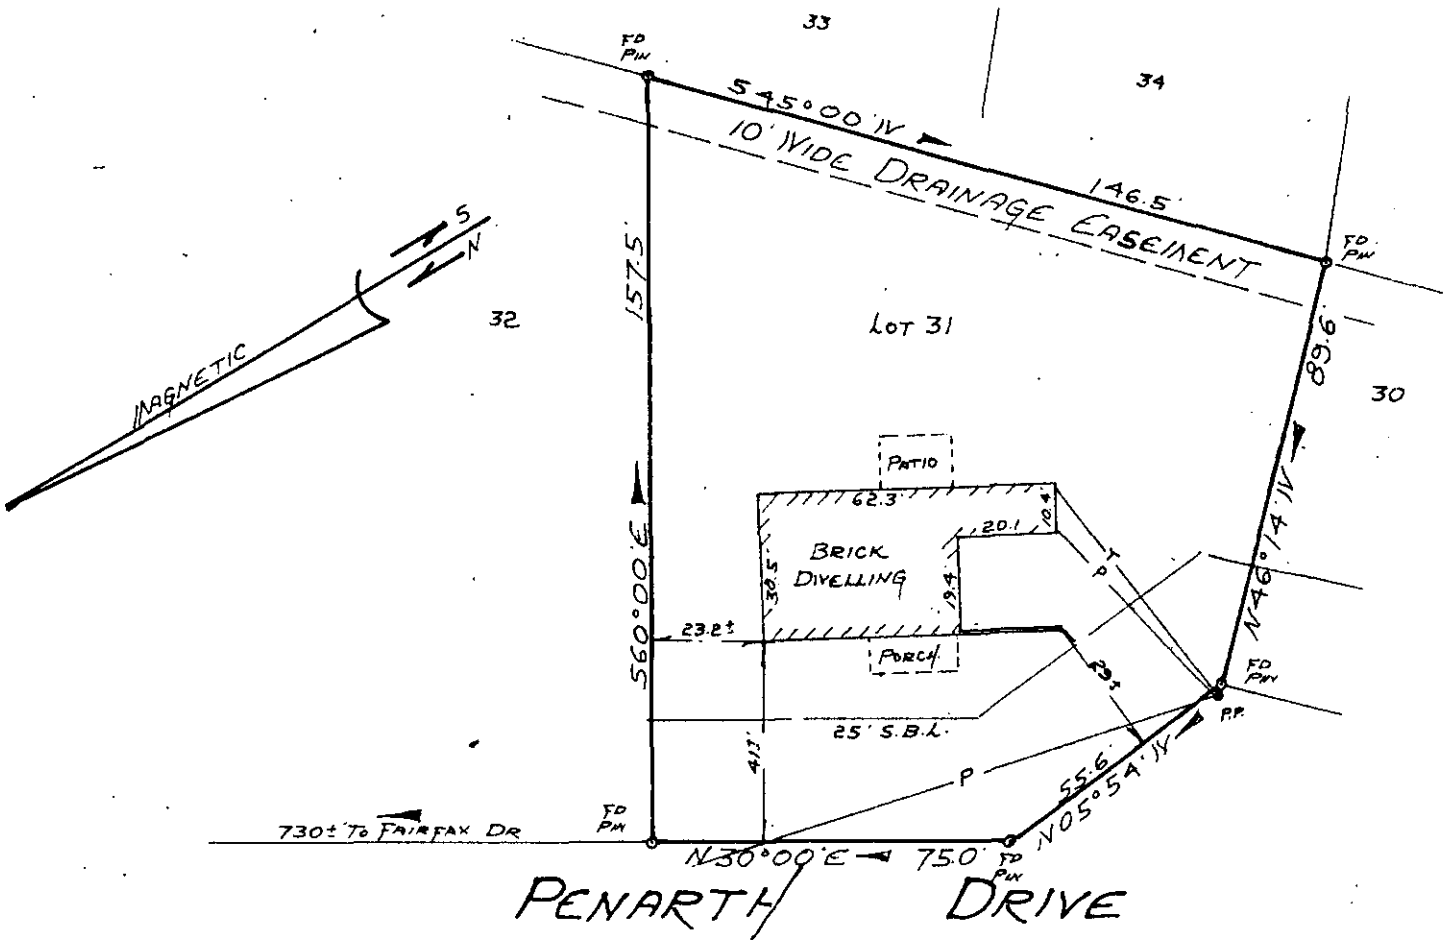

PROPERTY OF
DENNIS LAMAR WHITE
AND
JENNY B. WHITE
NEAR GREENVILLE, SO. CAROLINA
SCALE 1"=40' DEC. 27, 1977

This is to certify that on December 1977, I surveyed the property shown on this plat known as Lot No. 31 of Property of Central Realty Corp. as shown on a plat recorded in the RMC Office for Greenville County, in Plat Book EEE, at page 108, and that the property lines, walls and building are as shown hereon, and that the building located on said lot does not project nor encroach on adjacent streets or property, and that no adjacent walls or buildings project nor encroach on said lot, and that no utiltiy lines cross this lot except as may be shown hereon.

NOTE: This property is not located within a flood hazard area.

Survey by: Richard Wooten Land Surveying Co.

SOUTH CAROLINA REGISTERED LAND SURVEYOR
S. C. WOOTEN No. 1678

MICROFILMED

GCTO ----2 UE28 77 409

6-L-21

19380

1.00CI

FILED
GREENVILLE CO. S. C.
DEC 28 9 19 AM '77
DONNIE S. TANKERSLEY
R.M.C.