
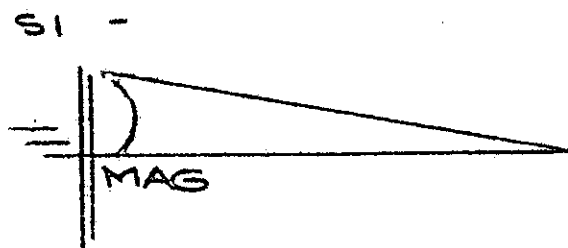


FILED  
 GREENVILLE CO. S. C.  
 DEC 30 10 50 AM '77  
 DONNIE S. TANKERSLEY  
 R.M.C.

SEMINOLE DRIVE  
 WATER & SEWER IN ST. R/W  
 N 89-47 W

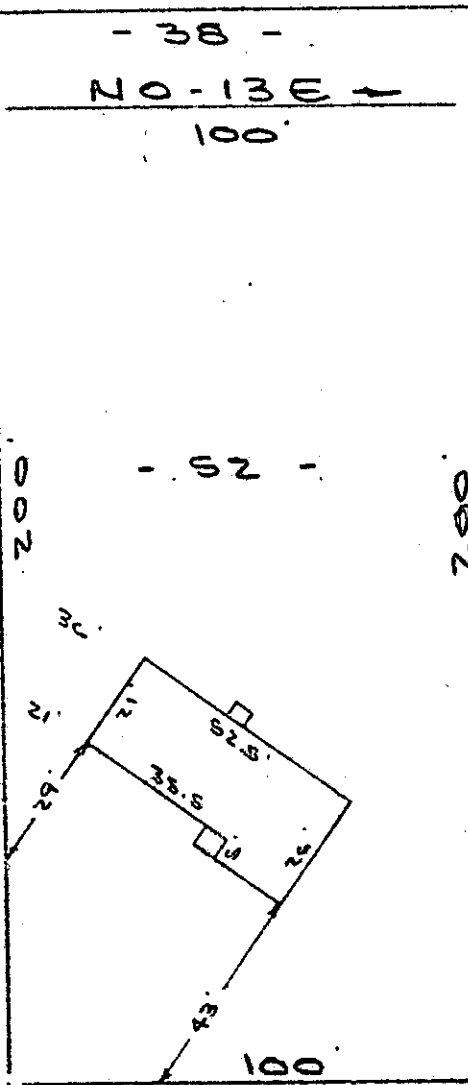

NOTE: Improvements on this lot are not in a flood hazard area.

CHYENNE DRIVE  
 WATER & SEWER IN ST. R/W

PROPERTY OF  
**GAIL M. LYONS & JEFFERY M. LYONS**  
 SIMPSONVILLE, SOUTH CAROLINA  
 SCALE: 1"=40' 2305C1A77

1 DE 30 77 520

This is to certify that on the 23rd day of December 1977, I surveyed the property shown on this plat, being known as lot 52 on plat of No. 4 WEST GEORGIA HEIGHTS and recorded in the H&C Office Greenville County, S. C., in Plat Book "CCC" at Page 151; and that the property lines, walls and buildings are as shown hereon, and that the walls and buildings located on said lot do not encroach or project on adjacent street or property, and that no adjacent walls or buildings encroach or project on said premises, and no power lines cross this property except as shown hereon.

16-L-25 19739  
 DEC 30 1977

*R. B. Bruce*  
 R. B. Bruce, RLS #1952  
 SOUTH CAROLINA REGISTERED LAND SURVEYOR NO. 1862  
 R. B. BRUCE

CAROLINA SURVEYING CO.  
 112 Manly St.  
 Greenville, S. C.

MICROFILMED

1.00C1