

NOTE: Improvements on this lot are not in a flood hazard area.

QUEEN STREET

PERRY AVENUE
WATER & SEWER IN ST R/W.

PROPERTY OF
LUTHER McCOMBS JR & THELMA DRUMMOND
GREENVILLE, S.C.
SCALE 1" = 40' 15 DEC 1977


FILED
GREENVILLE, CO. S.C.
JAN 3 3 57 PM '78
DONNIE STANKERSLEY
R.H.C.

This is to certify that on the 15th day of December, 1977, I surveyed the property shown on this plat, being known as PROPERTY OF LUTHER McCOMBS, JR. & THELMA DRUMMOND and recorded in the RMC Office Greenville County, S. C., in Plat Book at Page and that the property lines, walls and buildings are as shown hereon, and that the walls and buildings located on said lot do not encroach or project on adjacent street or property, and that no adjacent walls or buildings encroach or project on said premises, and no power lines cross this property except as shown hereon.

✓ 6-61-30

R. D. Brucc
R. D. Brucc, RLS #1952

JAN 3 1978

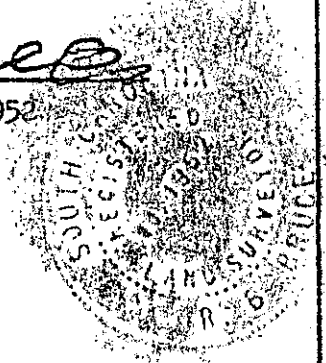

19902

CAROLINA SURVEYING CO.
112 Manly St.
Greenville, S. C.

MICROFILMED

GCTO ----- 3 JA. 577 1380 1.00CI

155 @ 46

123-13-24