


PROPERTY OF
 JAMES RONALD BERRY
 AND
 JUDITH C. BERRY
 NEAR GREENVILLE, SOUTH CAROLINA
 SCALE 1"=30' JAN 5, 1978

GCTO --- 1 JA 5 78 1035

This is to certify that on January 5, 1978, I surveyed the property shown on this plat, known as Lot No. 1 of Property of James E. Eaton and Barbara Ann Eaton, as shown on a plat recorded in the RMC Office for Greenville County, in Plat Book 6A, at page 92, and that the property lines, walls and building are as shown hereon, and that the building located on said lot does not project nor encroach on adjacent streets or property, and that no adjacent walls or buildings project nor encroach on said lot, and that no utility lines cross this lot except as may be shown hereon.

NOTE: This property is not located within a flood hazard area.

Survey by: Richard Wooper Land Surveying Co.

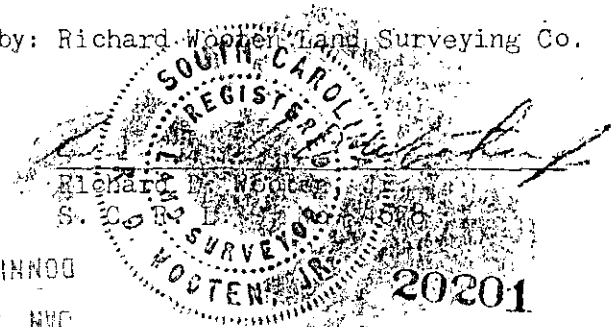

DONNIE S. TANKERSLEY
 R.M.C.
 JAN 5 2 43 PM '78
 GREENVILLE, CO. S.C.

6-7-35

MICROFILMED
 JAN 5 1978

1.000C1