


RASOR DR.
 PROPERTY OF
 CHARLES A. JONES, II
 AND
 JOAN G. JONES
 NEAR GREENVILLE, SOUTH CAROLINA
 SCALE 1" = 40' JAN 19, 1978

This is to certify that on January 19, 1978, I surveyed the property shown on this plat, known as Property of Charles A. Jones II, and Joan G. Jones, as shown on a plat recorded in the RMC Office for Greenville County, in Plat Book _____, page _____ and that the property lines, walls and building are as shown hereon, and that the building located on said lot does not project nor encroach on adjacent streets or property, and that no adjacent walls or buildings project nor encroach on said lot, and that no utility lines cross this lot except as may be shown hereon.

NOTE: This property is not located within a flood hazard area.


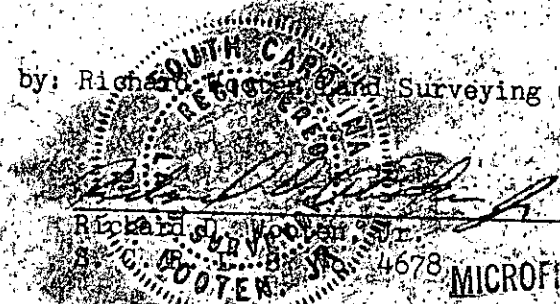

21935

R.M.C.
 DONNIE S. TANKERSLEY

 84678

MICROFILMED

✓ 6-2-59

JAN 24 9 42 AM '78

FILED
 GREENVILLE CO. S.C.

227

1.00CI