

FILED  
GREENVILLE CO. S. C.

JAN 31 3 01 PM '78

DONNIE S. TANKERSLEY  
R.M.C.

INN CIRCLE

PROPERTY OF  
CECIL J. LUKE

AND

JANICE E. LUKE

FOUNTAIN INN, SOUTH CAROLINA  
SCALE 1"=40' JAN 25, 1978


✓ 6-L-84

GCTO -----2 JAS 78 12 78 1,000CI

This is to certify that on January 25, 1978, I surveyed the property shown on this plat, known as a major portion of lot no. 2 of Property of Gene A. Cook, as shown on a plat recorded in the RMC Office for Greenville County, in Plat Book QQQ, at page 29, and that the property lines, walls and building are as shown hereon, and the building located on said lot does not project nor encroach on adjacent streets or property, and that no adjacent walls or buildings project nor encroach on said lot, and that no utility lines cross this lot except as may be shown hereon.

NOTE: This property is not located within a flood hazard area.

Survey by: Richard P. Wooten and Surveying Co.

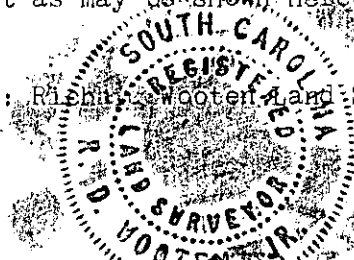

MICROFILMED

Richard P. Wooten Jr.  
S. C. R. L. S. No. 4678

22630