


MICROFILMED

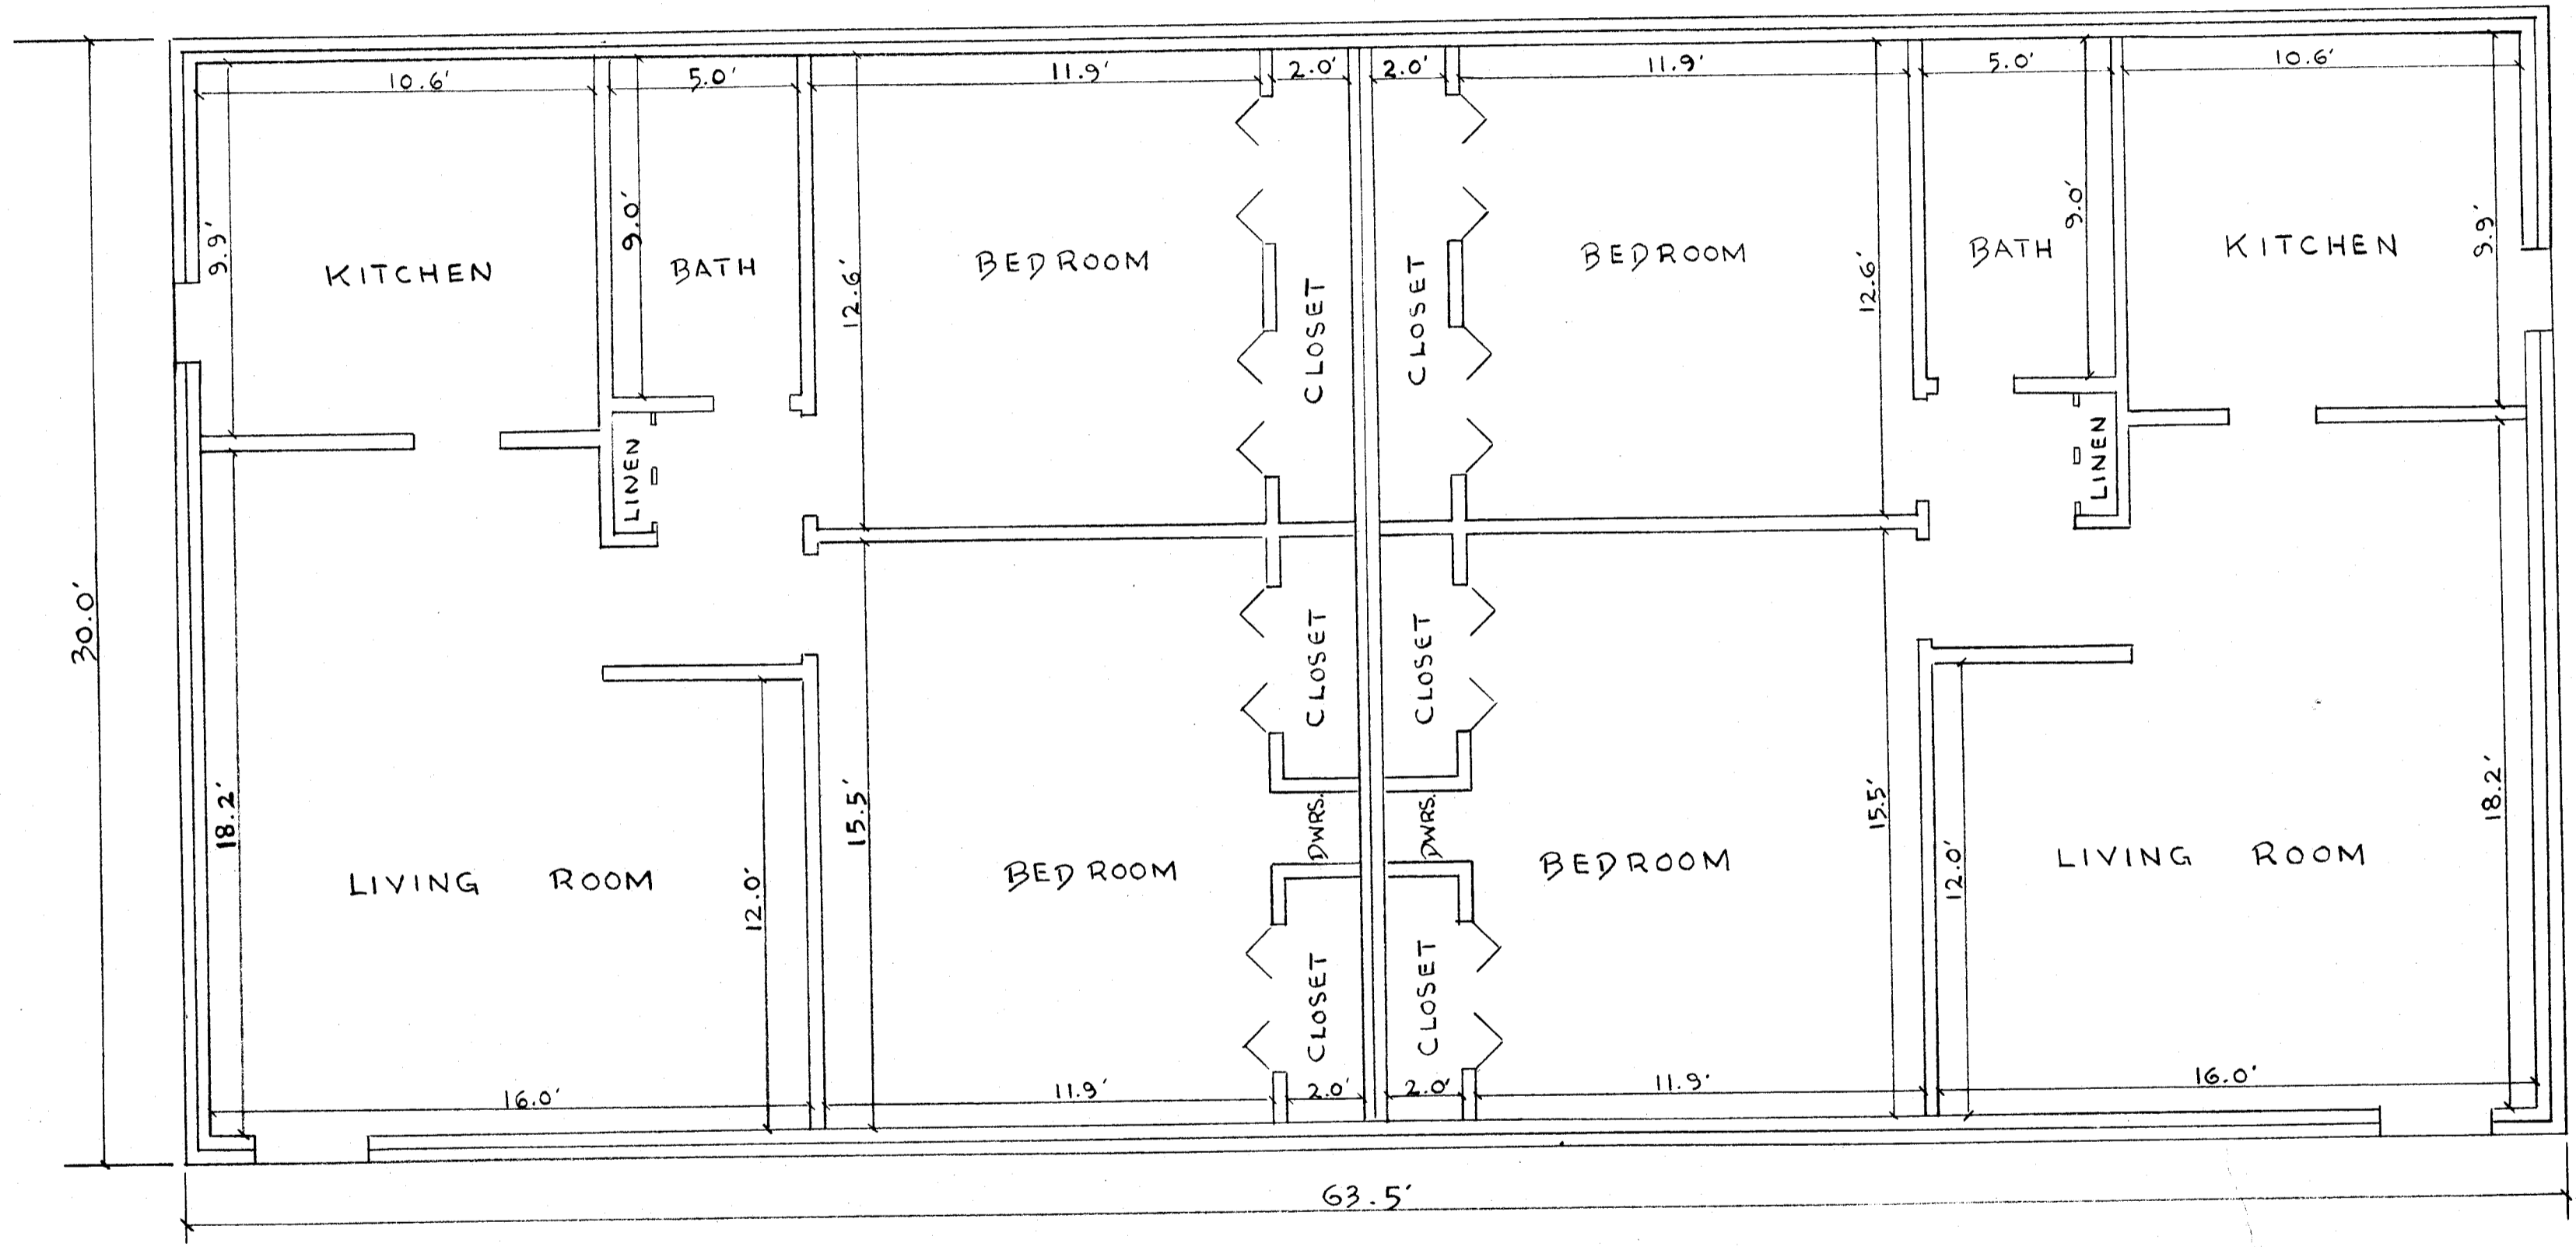


FLOOR PLAN B
SCALE 1" = 4'

THIS IS TO CERTIFY THAT THIS FLOOR PLAN WAS DRAWN FROM AN ACTUAL FIELD MEASUREMENT AT YEARGIN PROPERTIES, INC. KNOXBURY TERRACE

32987

FILED
GREENVILLE CO. S.C.
MAY 5 11 09 AM '78
DONNIE S. TANKERSLEY
R.M.C.

6-M-47

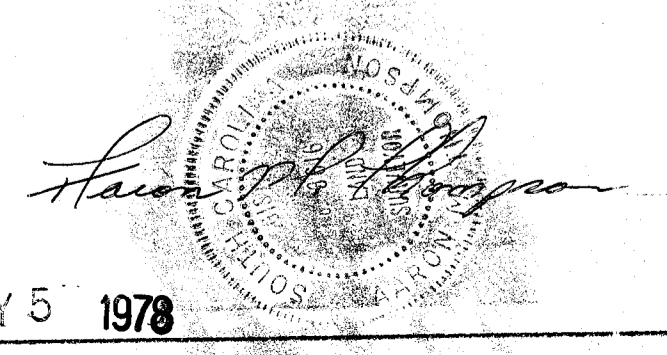

1000-50001 813 8/57-1 --- GCTC