


FILED  
GREENVILLE CO. S.C.  
JUL 5 1 20 PM '78  
DONNIE S. TANKERSLEY  
R.M.C.

CHARLES F. TURNER & JOANNE G. TURNER

PIEDMONT HEALTH CARE CORPORATION

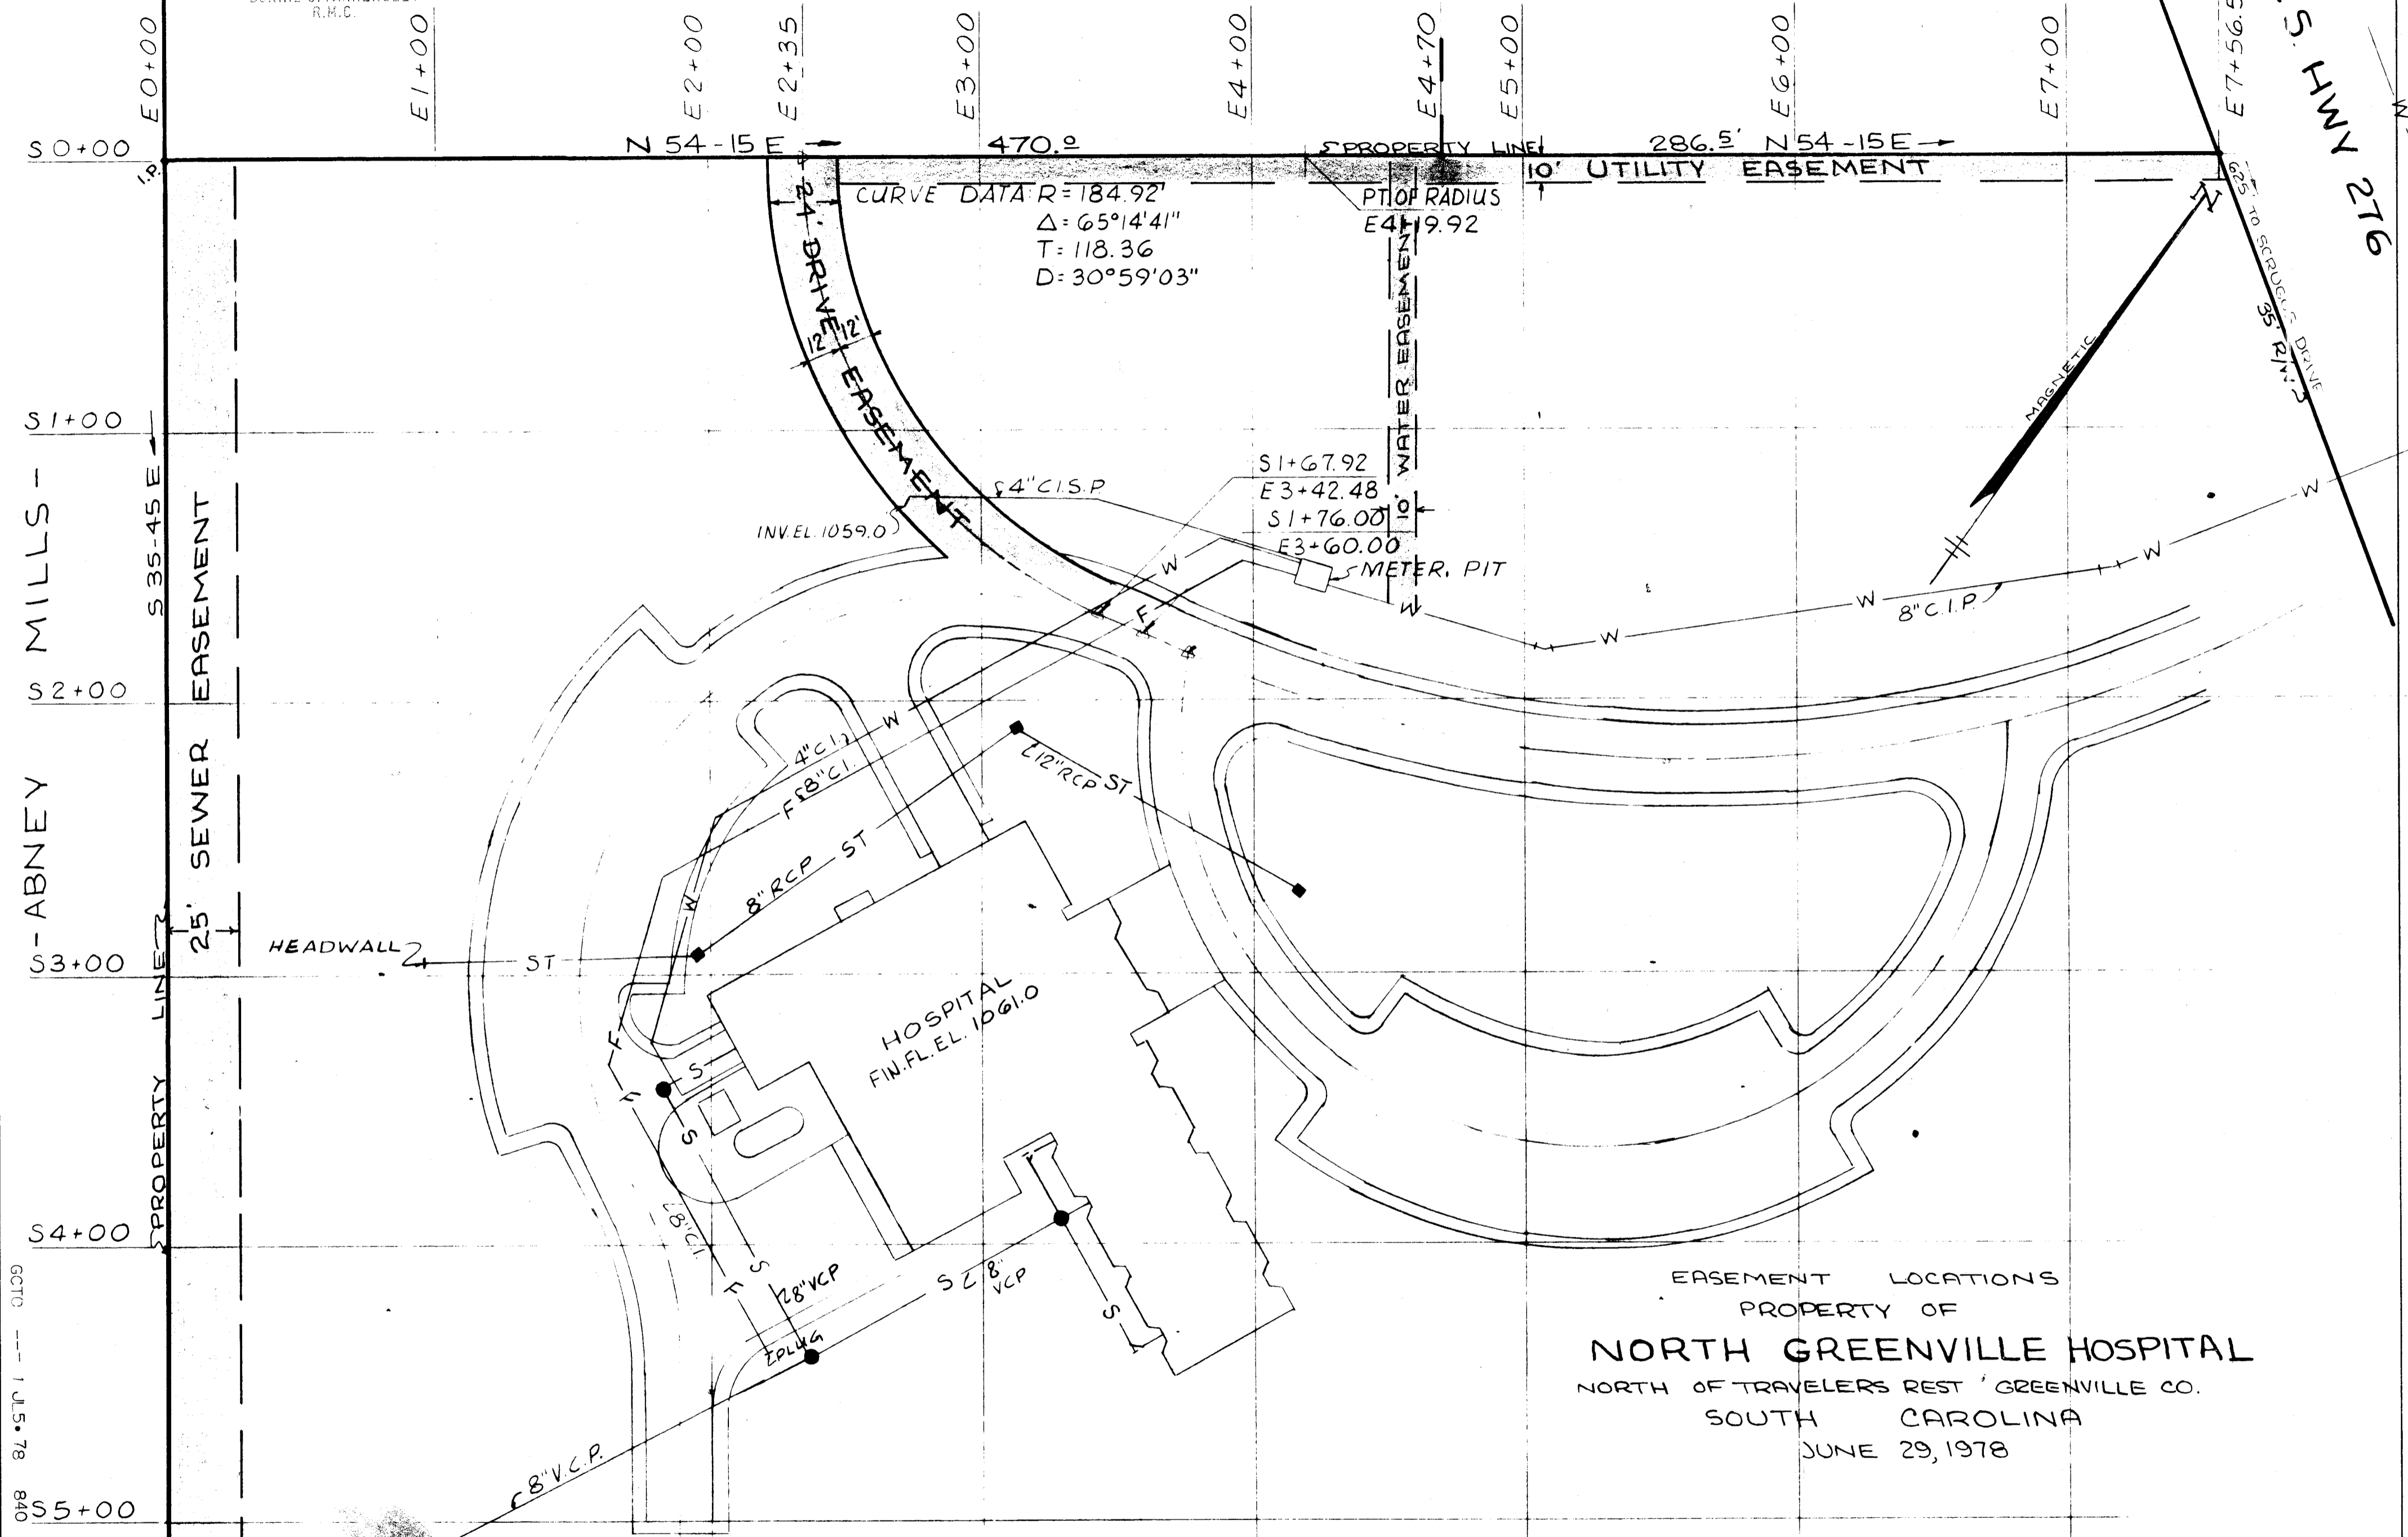

EASEMENT LOCATIONS  
PROPERTY OF  
**NORTH GREENVILLE HOSPITAL**  
NORTH OF TRAVELERS REST, GREENVILLE CO.  
SOUTH CAROLINA  
JUNE 29, 1978



GCTO --- 1 JUL 5 78 840 3.0001

16-M-78

506.6-1-PT 1

SCALE 1"=40'

MICROFILMED