


FILED
GREENVILLE CO. S. C.

AUG 22 1 05 PM '78

DONNIE S. TANKERSLEY
R.M.C.

MICROFILMED

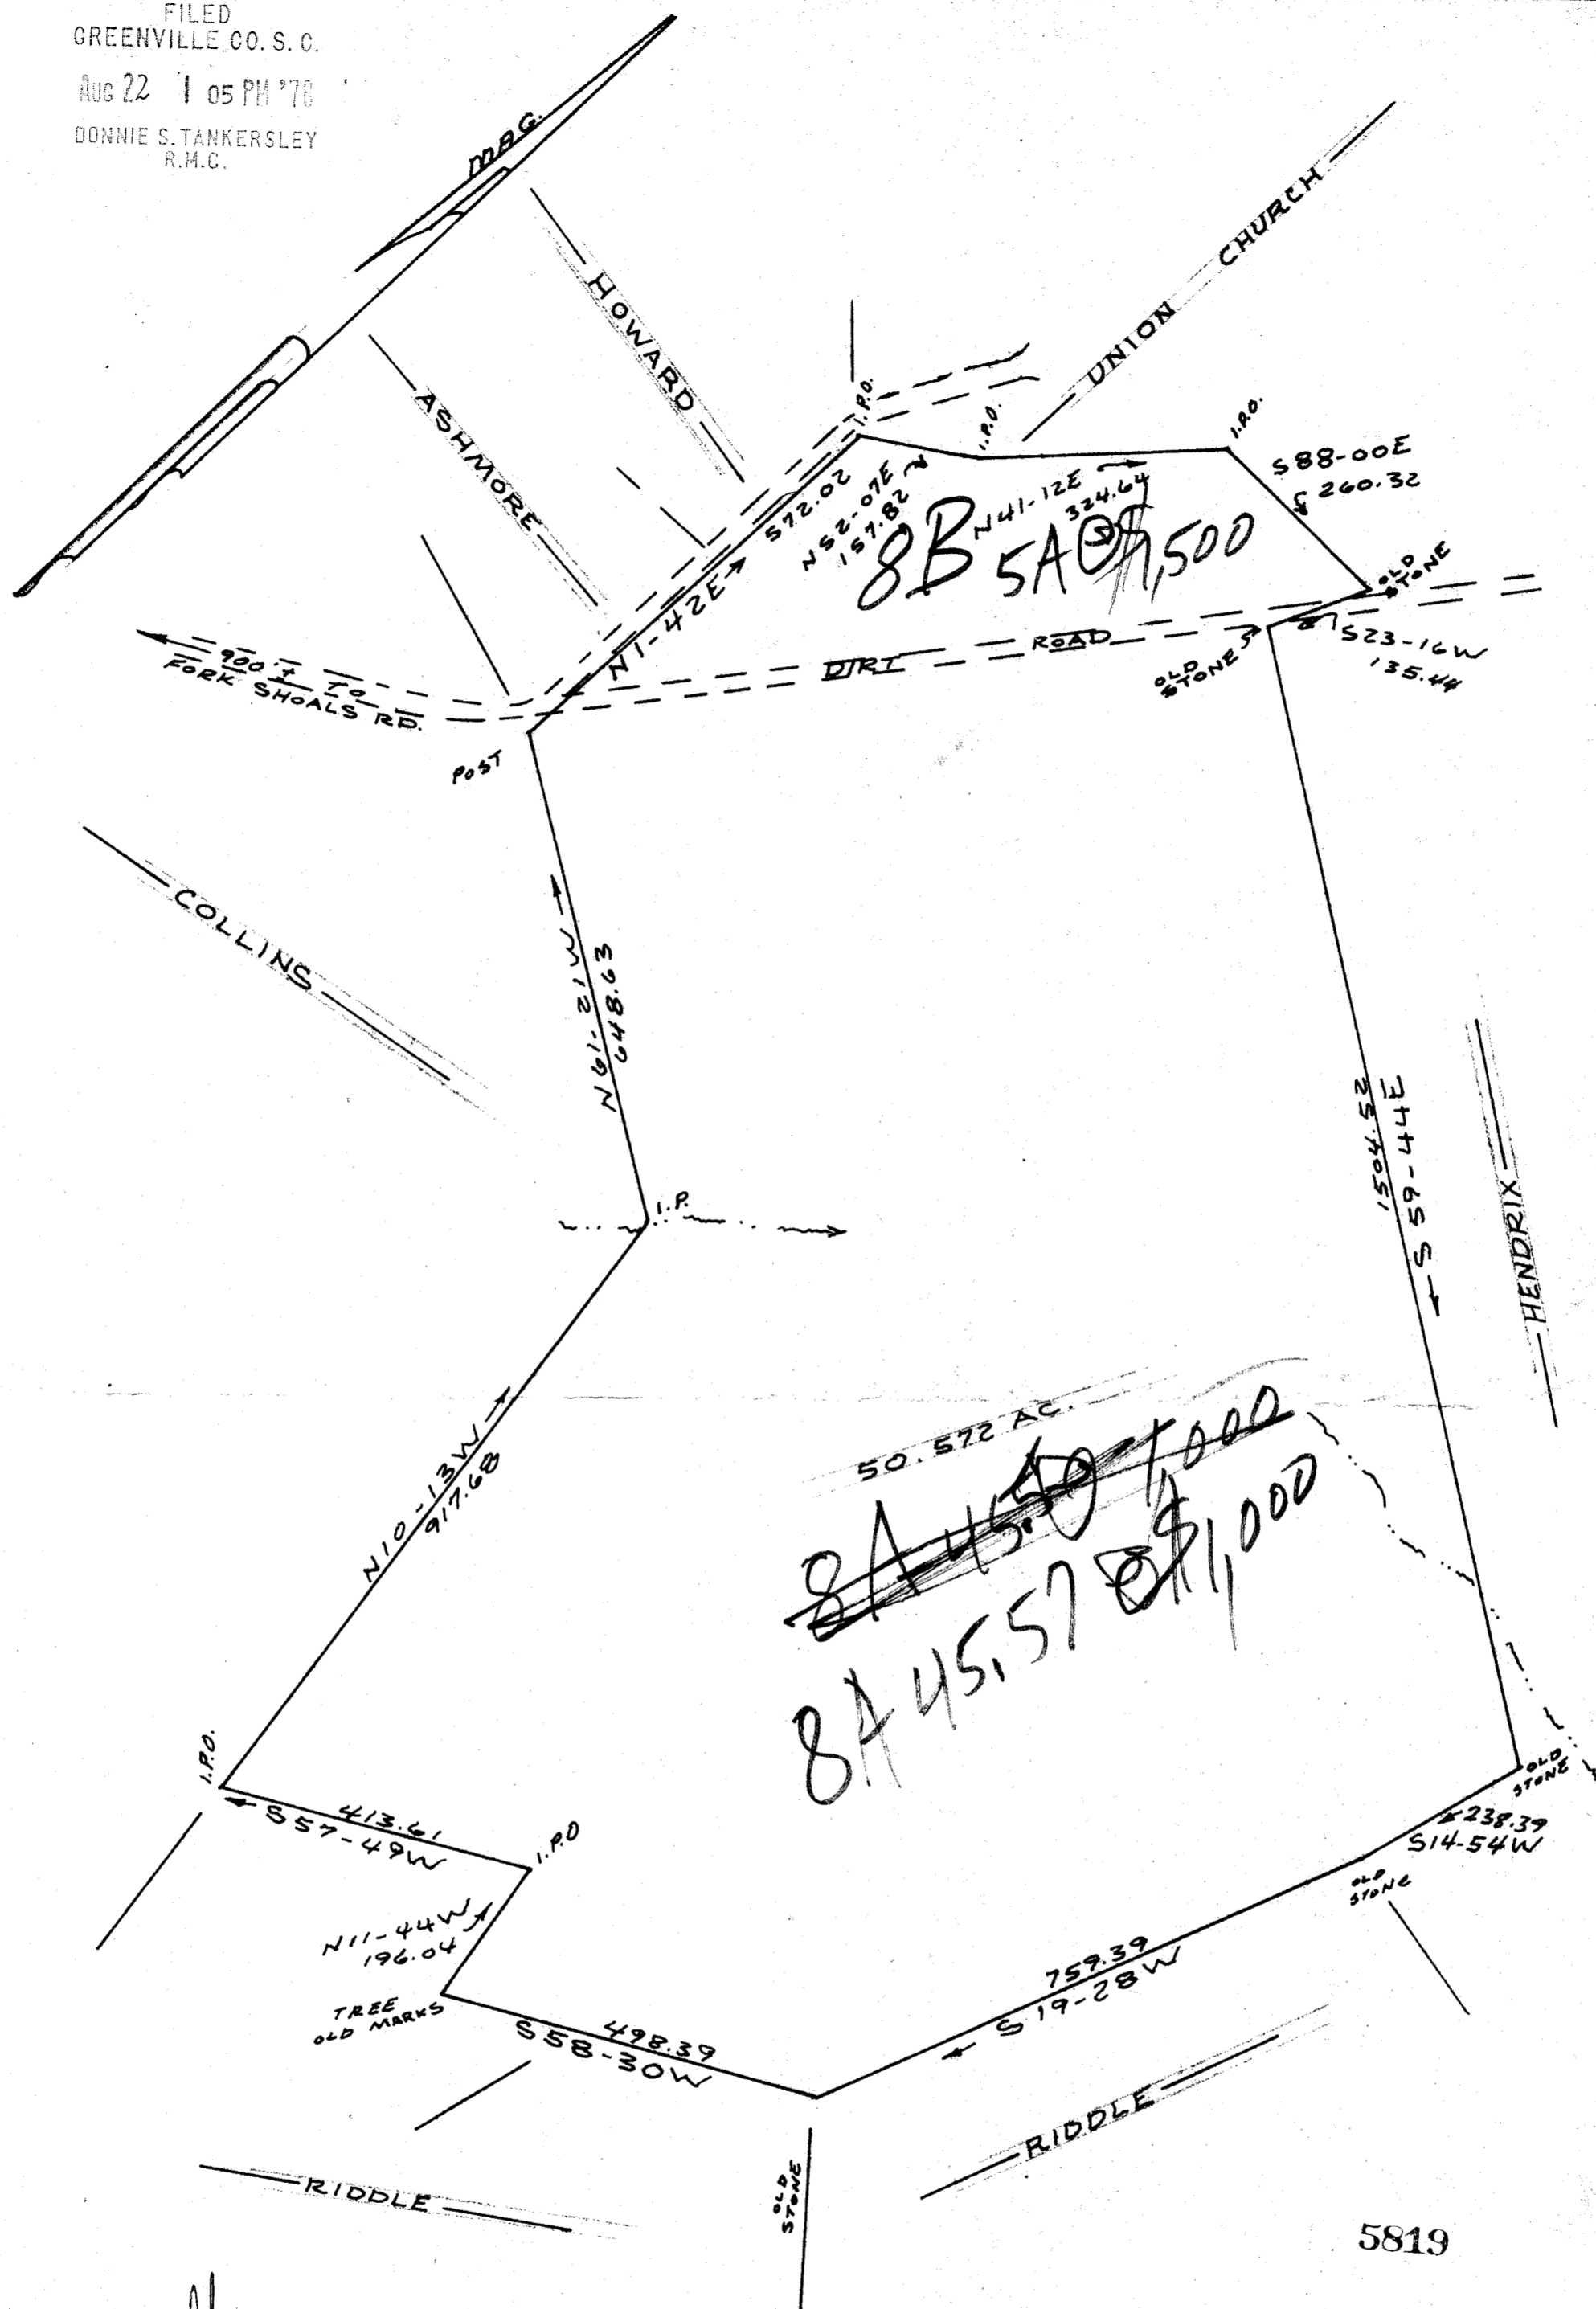

~~8A 45.57 @ \$1,000~~
 8A 45.57 @ \$1,000

PLAT FOR

HENRY P. WILLIMON

GREENVILLE COUNTY S. C.

WEBB SURVEYING & MAPPING CO.

SCALE 1" = 200'

OCT. 1977

✓ 6M-91

AUG 22 1978

