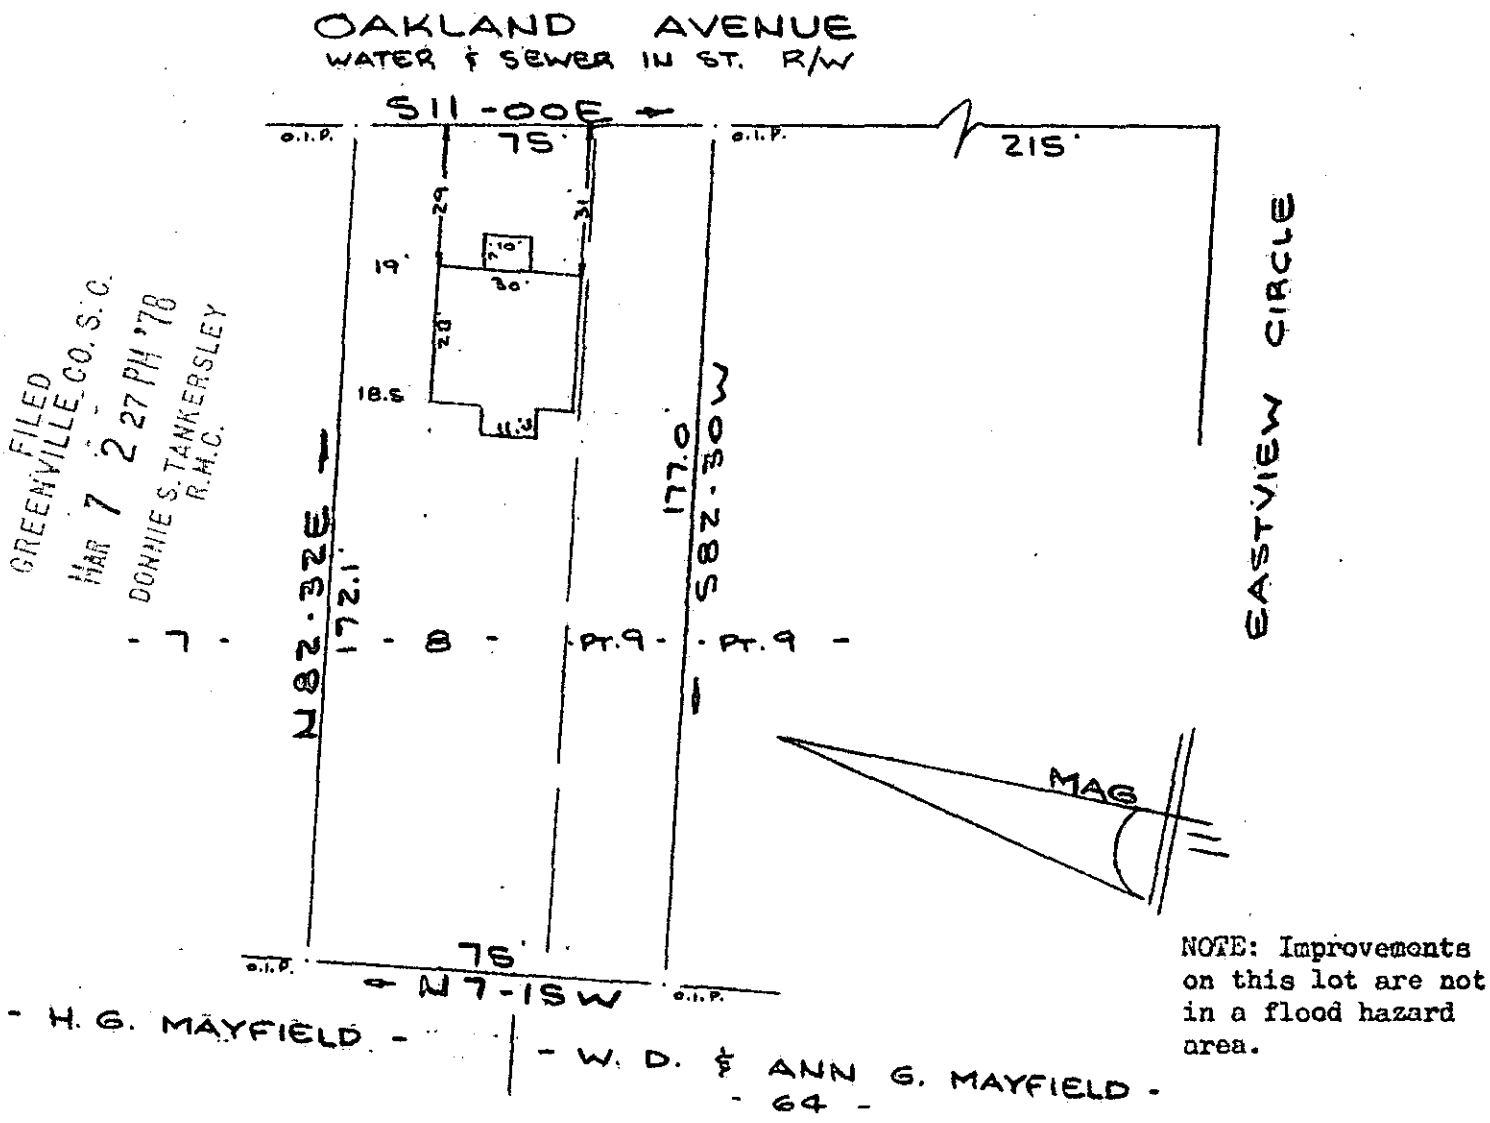

NOTE: Improvements on this lot are not in a flood hazard area.

FILED
GREENVILLE CO. S. C.
MAR 7 2 27 PM '78
DONNIE S. TANKERSLEY
R.H.C.

PROPERTY OF

J. B. MARLAR

SIMPSONVILLE, SOUTH CAROLINA

SCALE: 1" = 40' 28FEB1978

This is to certify that on the 28th day of February, 1978, I surveyed the property shown on this plat, being known as lot 8 and part of lot 9 on plat of MOORE HEIGHTS and recorded in the RMC Office Greenville County, S. C., in Plat Book " A " at Page 391; and that the property lines, walls and buildings are as shown hereon, and that the walls and buildings located on said lot do not encroach or project on adjacent street or property, and that no adjacent walls or buildings encroach or project on said premises, and no power lines cross this property except as shown hereon.

26203 V6N-68

R. B. Bruce

R. B. Bruce, RLS

MAR 7 1978

CAROLINA SURVEYING CO.
112 Manly St.
Greenville, S. C.

MICROFILMED

GCTO --- 1 MR 7 78 160

1.00CI