


FILED
GREENVILLE, CO. S. C.

MAR 22 9 23 AM '78

DONNIE S. TANKERSLEY
R.M.C.

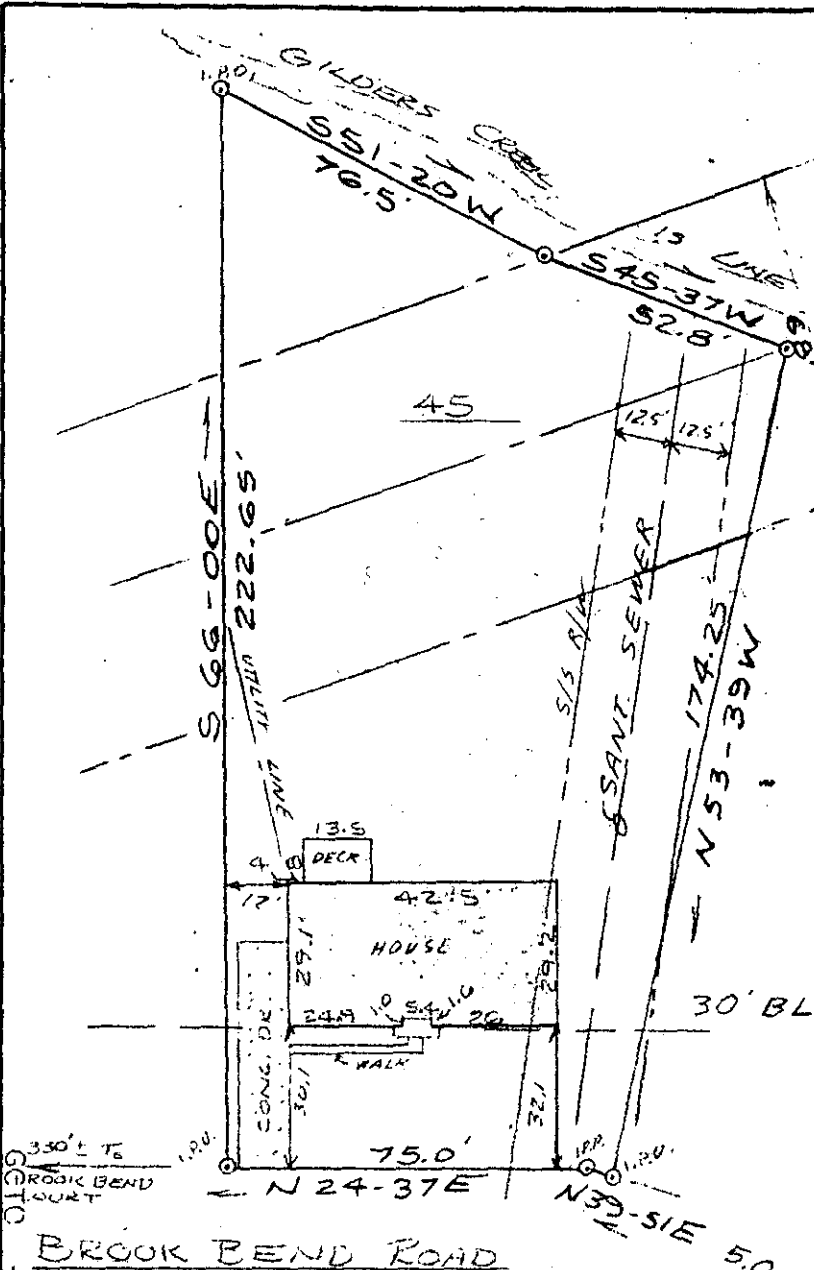

This is to certify that on March 16, 1978, I surveyed the property shown on this plat, known as Lot 45 on Plat of Holly Springs, Sec. 1, recorded in the RMC Office of Greenville County in Plat Book 4N on Page 5, and that the property lines, walls and buildings are as shown hereon; that the building located on said lot does not encroach or project on adjacent streets or property, and that no adjacent walls or buildings encroach or project on said premises, and that no utility lines cross this property except as shown hereon.

James R. Freeland

James R. Freeland RLS & PE 4781

BROOK BEND ROAD

"his property is located
in a flood hazard area.

27814

6-71-91

MAR 22 1978



**STATE OF SOUTH CAROLINA
GREENVILLE COUNTY**

FREELAND & ASSOCIATES
Engineers • Land Surveyors

GREENVILLE, S. C.

HOLLY SPRINGS - SECTION 1

LOT No. 45

PROPERTY OF

MICHAEL D. UNDERWOOD
DEBORAH E. UNDERWOOD

SURVEY B.H.

DRAWN J.S.

CHECK M.C.

SCALE 1"=40'

DATE 3-27-78

DWG. NO. 78-2033

SEAL MICROFILMED

1 MR22 78 207 1.00CT