


(SULPHUR SPRINGS ROAD)
FRANKLIN ROAD

FILED
GREENVILLE CO. S. C.
MAR 23 8 48 AM '78
DONNIE S. TANKERSLEY
R.M.C.

BUNCOMBE ROAD

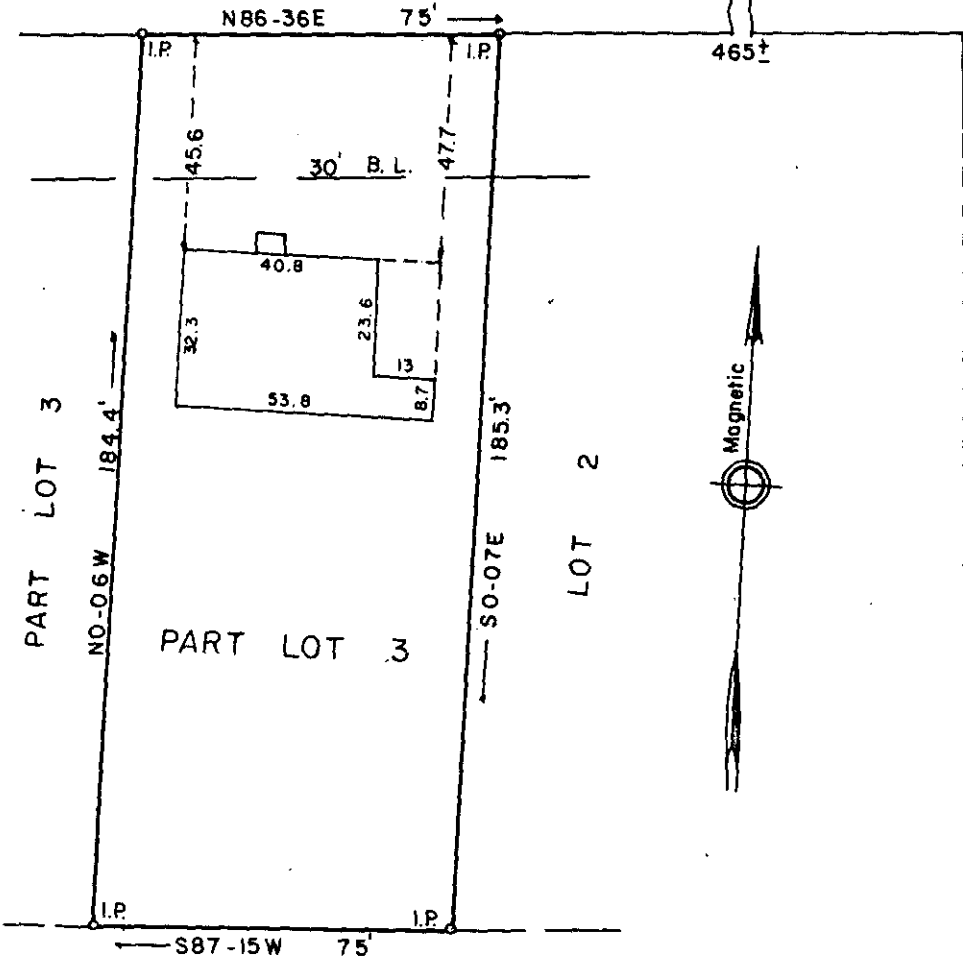

PROPERTY OF

JACKEY LEE CHAPMAN

AVA R. CHAPMAN


GREENVILLE CO., S.C.

6-7-93
MAR 23 1978

Scale 1" = 40' March, 1978

27939

This is to certify that on the 14th day of March, 1978, We surveyed the property shown on this plat; being known as part of Lot 3 on property of D. B. Tripp, Recorded in Plat Book Y page 15, Office of R. M. C. Greenville, S. C. and that the property lines, walls and buildings are as shown hereon; that the buildings located on said lot do not encroach or project on adjacent streets or property; and that no adjacent buildings or walls encroach or project on said premises; and from information from Greenville County, this structure is not in a designated flood area.

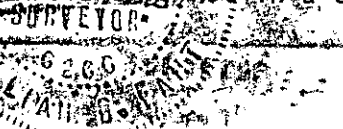

Dalton & Neves Co., Engineers

S.C. Reg. No. 6266

F.B. 427

MICROFILMED

GCTD --- 2 MR 23 78 401 1.00CI