

FILED  
 GREENVILLE CO. S. C.  
 APR 25 11 52 AM '78  
 DONNIE S. TANKERSLEY  
 R.M.C.

PROPERTY OF  
DAVID E. KELLY &  
DEBORAH D. KELLY  
 GREENVILLE, SOUTH CAR.  
 APRIL 11, 1978 SCALE: 1" = 50'


This is to certify that on April 11, 1978, I surveyed the property shown on this plat known as Lot No. 5 of Block "B", Property of H. K. Townes, as shown on a plat recorded in the RMC Office for Greenville County, in Plat Book W, at page 13, and that the property lines, walls and building are as shown hereon, and that the building located on said lot does not project nor encroach on adjacent streets or property, and that no adjacent walls or buildings project nor encroach on said lot, and that no utility lines cross this lot except as may be shown hereon.

NOTE: This property is not located within a flood hazard area.

Survey by: Richard Wooten Land Surveying Co.  
 Greenville, South Carolina

APR 25 1978

31616

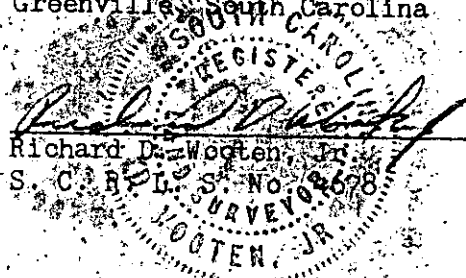

V6-0-59

GCTO --- 2 APR 25 78 949 1.00CI

MICROFILMED

See Plat B/C "C"