


MILLER STREET (WEST AVE)
WATER & SEWER IN S. R.W.

S17-20E

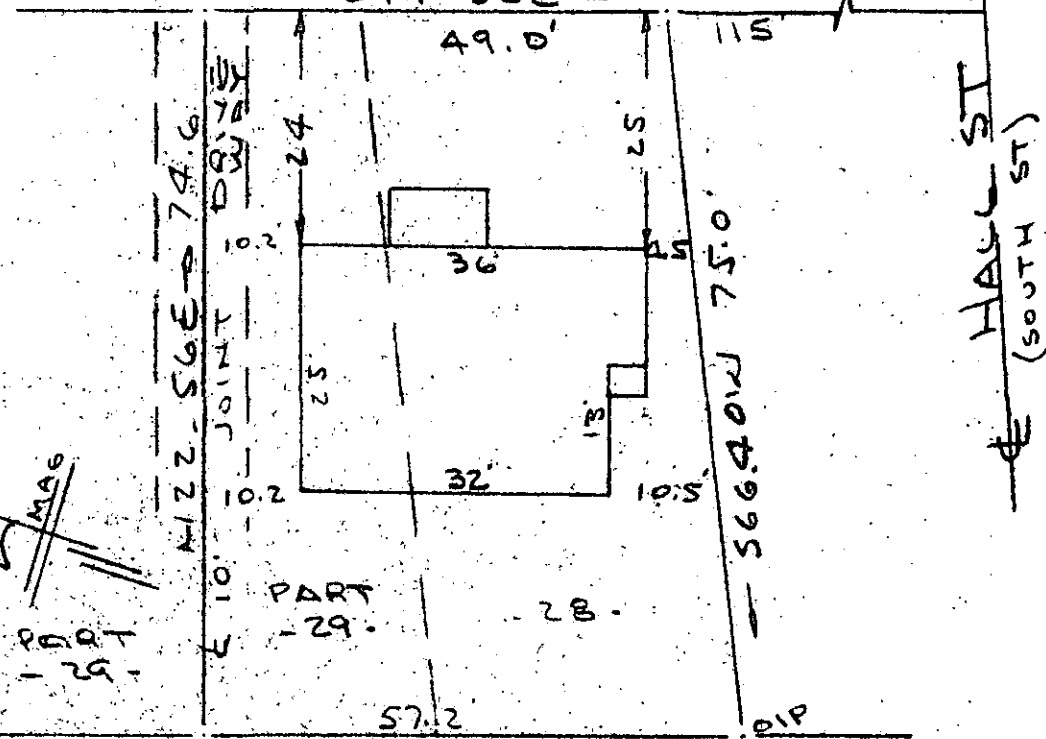

FILED
GREENVILLE CO. S.C.
APR 26 11 26 AM '78
DONNIE S. TANKERSLEY
R.M.C.

NOTE: Improvements on this lot are not in a flood hazard area,

PROPERTY OF
RALPH BLASSINGAME & HAZEL BLASSINGAME
GREENVILLE, S.C.
SCALE 1" = 20' 24 APRIL 1978

This is to certify that on the 24th day of April, 1978, I surveyed the property shown on this plat, being known as lot 28 and part of lot 29 on plat of RALPH BLASSINGAME & HAZEL BLASSINGAME recorded in the RMC Office Greenville County, S. C., in Plat Book at Page; and that the property lines, walls and buildings are as shown hereon, and that the walls and buildings located on said lot do not encroach or project on adjacent street or property, and that no adjacent walls or buildings encroach or project on said premises, and no power lines cross this property except as shown hereon.

R. B. Bruce
R. B. Bruce, RLS #1952

31770

✓ 6-0-63

CAROLINA SURVEYING CO.
112 Manly St.
Greenville, S.C. 29678 C1215

