



FILED
GREENVILLE CO. S. C.

MAY 17 11 00 AM '78

DONNIE S. TANKERSLEY
R.M.C.

OVERBROOK ROAD

WOODVILLE AVENUE

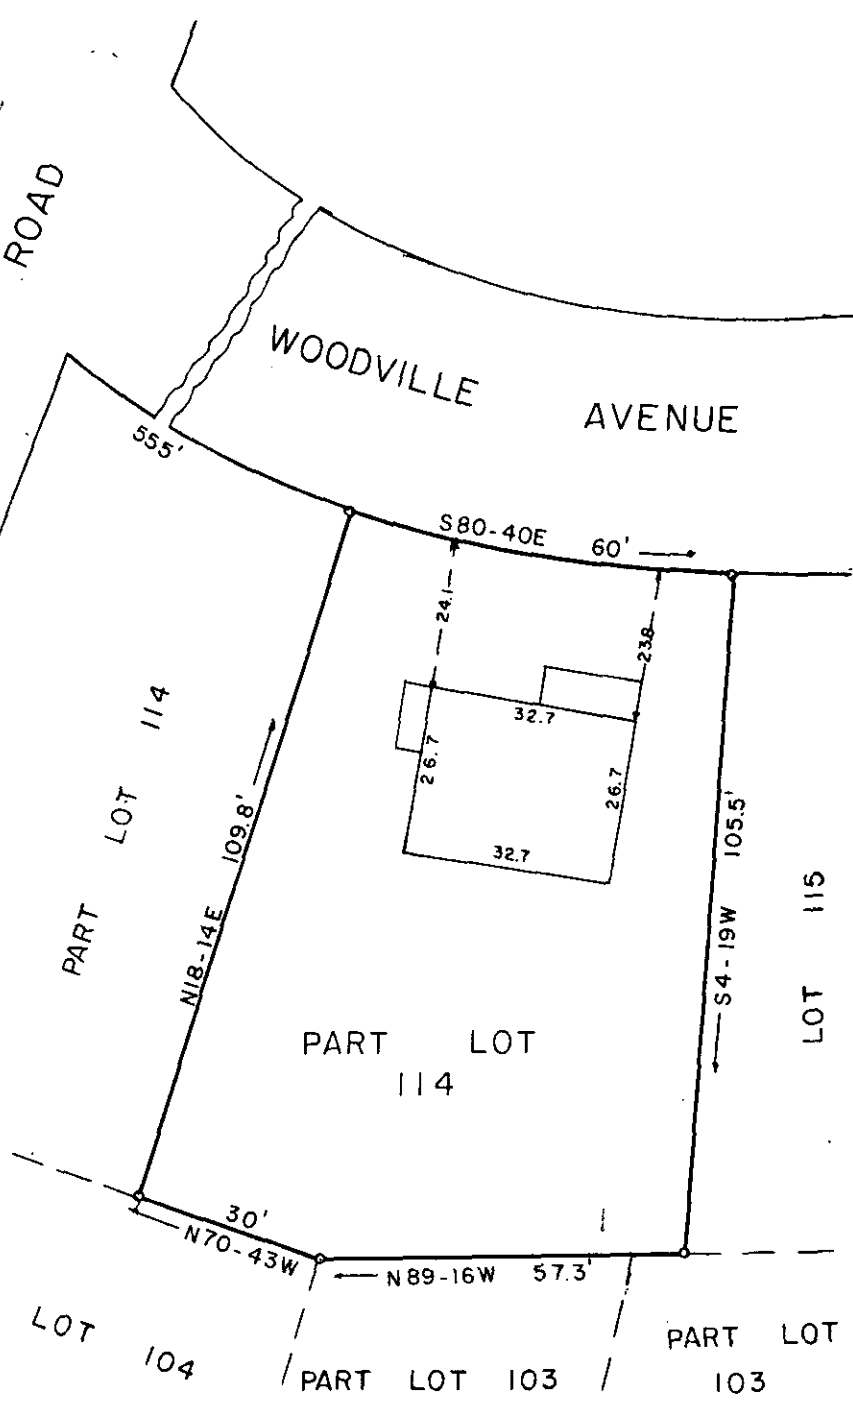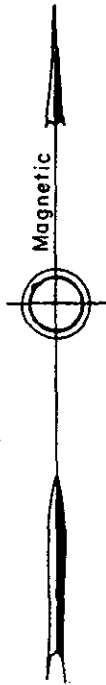

PROPERTY OF

JOHN S. WHITEHEAD

BUNNY F. MILLER

GREENVILLE CO., S.C.

34322

Scale 1" = 30' April, 1978

6-Q-26

MAY 17 1978

This is to certify that on the 28th day of April, 1978, We surveyed the property shown on this plat; being known as part of Lot 114 on Plat 5 of Overbrook Land Co. and Woodville Inv. Co., Recorded in Plat 1 of Overbrook Land Co., page 218, Office of R. M. C. Greenville Co., S. C.; and that the property lines, walls and buildings are as shown hereon; that the buildings located on said lot do not encroach or project on adjacent streets or property; and that no adjacent buildings or walls encroach or project on said premises; and from information from Greenville County, this structure is not in a designated flood area.

William B. Fant
Dalton & Neves Co., Engineers
MICROFILMED

GCTD -----2 MY17 78 167
1-DOCI