
FILED MAY 26,4:25 P.M."78 DONNIE S. TANKERSLEY RMC

MICROFILMEL

BROOK FOREST DR.

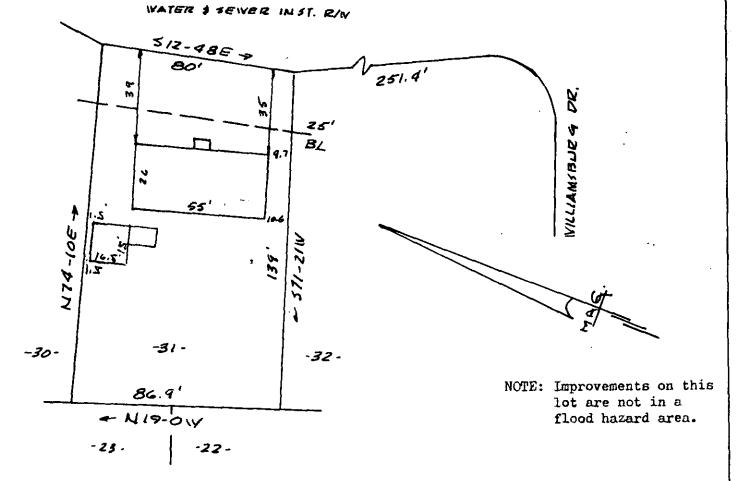

PROPERTY OF

GHOLIKELEY & ELLA BARBARA J. GHOLIKELEY NEAR GREENVILLE, S.C. SCALE 1"-40' 22 May 1978

This is to certify that on the 22 tod day of MAY 3978, I surveyed the property shown on this plat, being known as lot 31 on plat of Section 1 and 2 BELLE MEADE and recorded in the R.M.C. Office Greenville County, S.C. in plat book "EE" page 116 and 117; and that the property lines, walls and buildings are as shown hereon, and that the buildings located on said lot do not encroach or project on adjacent street or property, and that ho adjacent buildings or walls encroach or project on said premises.

35421

6°Q-54 MAY 26 1978

112 Hanly St., Greenville, S.

1.00CI

4243