FILED
GREENVILLE CO. S.C.
JUL 3 1 11 PM '78
DONNIE S. TANKERSLEY
R.M.C.

MICROFILMED

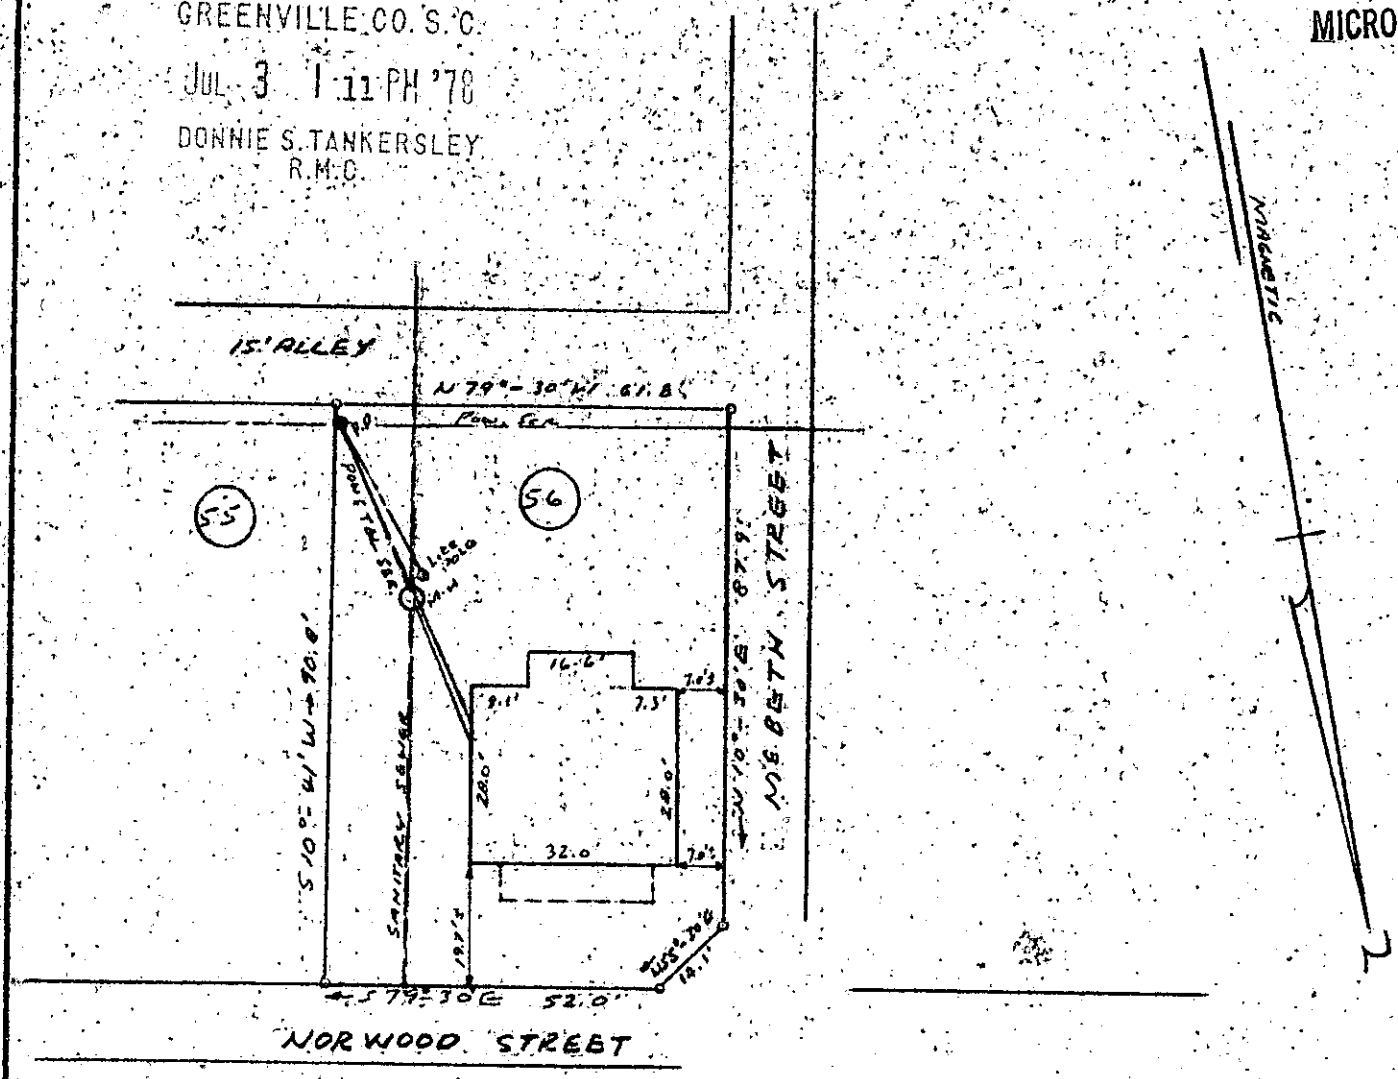

PROPERTY OF
MARSHALL S. DUNCAN &
SANDRA DUNCAN
GREENVILLE, SOUTH CAROLINA
JUNE 28, 1978 SCALE 1" = 30'

This is to certify that on June 28, 1978, I surveyed the property shown on this plat, known as Lot No. 56 of Section No. 3 of Victor Monaghan Mills as shown on a plat recorded in the RMC Office for Greenville County in Plat Book S at pages 179 - 181, and that the property lines, walls and buildings are as shown hereon, and that the building located on said lot does not project nor encroach on adjacent streets or property, and that no adjacent walls or buildings project nor encroach on said lot, and that no utility lines cross this lot except as may be shown hereon.

NOTE: This property is not located within a flood hazard area.

Survey by: Richard Wooten Land Surveying Co.
Greenville, South Carolina

Richard D. Wooten, Sr.
S. C. R. L. S. No. 4678

JUL 3 1978

153

✓6 R - 40

GC10 ——— 3 JUL 78 10:53

1.00CI