
MICROFILMED

- OPEN

AREA

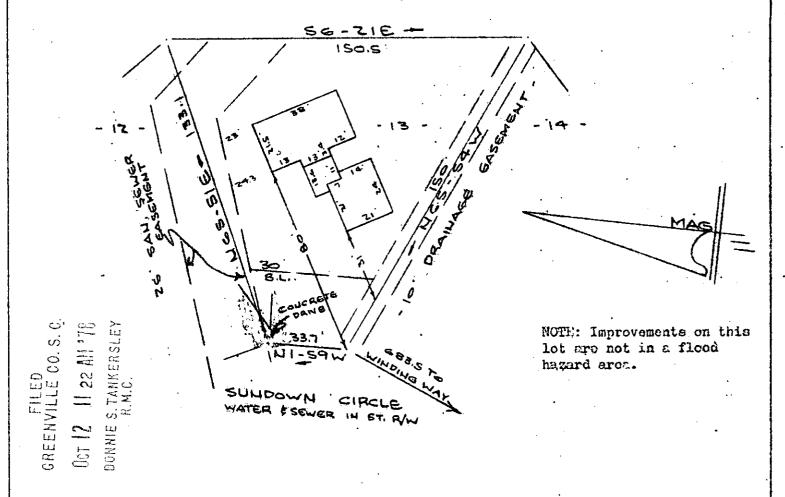

PROPERTY OF

RICHARD VALIOY SUDDUTH & STEPHEN EDWARD ADYMAN, JR.

BEAR GREENVILLE, S. C.

SCALE: 1" 40 90071978

This is to certify that on the 9th day of October, 1978, I surveyed the property clown on this plat, being known as lot 13 on plat of PROPERTY OF BRENT CORPORATION and recorded in the RNC Office Greenville County, E. C., in Plat Book is hear if the ct Page 142; and also being known as PROPERTY OF RICHARD VANOY-SUDDUTH & STAPHED EDMARD ADMEAN, J.L. and recorded in Plat Book at Page; and that the property lines, walls and buildings are as shown hereon, and that the walls and buildings located on said lot do not encroach or project on adjacent street or property, and that no adjacent walls or buildings encroach or project on said premises, and no power lines cross this property except as shown hereon.

16W-30

11667

R. B. Bruce, RIS #1952

OCT 1 2 1978

CAROLINA SURVEYING CO.

1:0001