FILED
GREENVILLE CO. S. C.
Nov 1 10 15 AM '78
DONNIE S. TANKERSLEY
R.M.C.

MICROFILMED

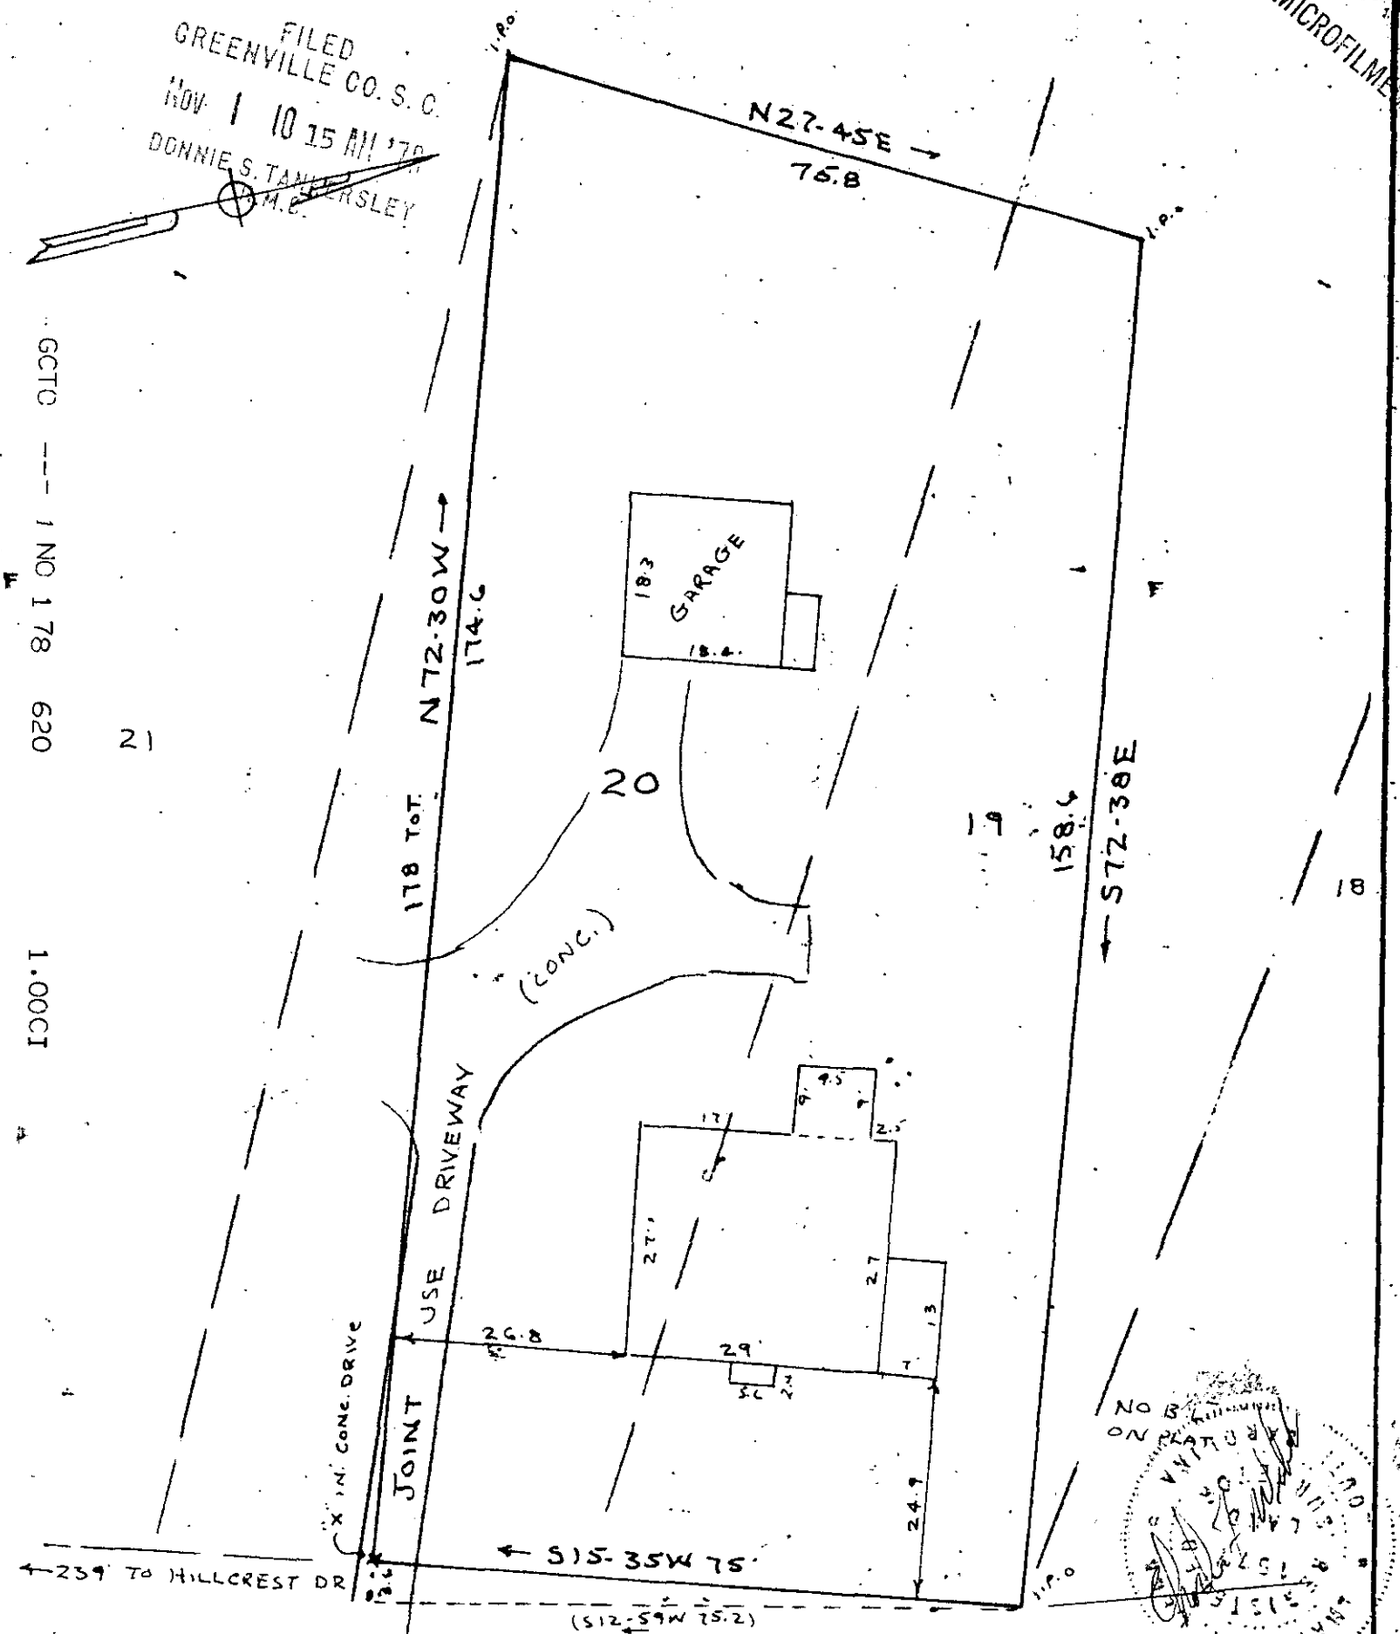

HILLCREST 13730 CIRCLE

THIS PLAT FOR RECORDING

I hereby certify that on Oct. 19, 1978 I surveyed portion of lots 19 and 20 of Hillcrest Circle dated Sept. 1928 and recorded in plat Book "H" on page 129 in the R.M.C. Office Of Greenville County, and that the property lines, buildings, and walls are as shown hereon, that no walls or buildings encroach on adjacent streets or property and no walls or buildings encroach or project on these premises except as shown and the structures are not within a food hazard area.

Charles F. Webb R.L.S.

CHARLES F. WEBB
REGISTERED
1577
LAND SURVEYOR
SOUTH CAROLINA

6-W-82

PROPERTY OF
L. JERRY CHAPMAN
MARY FRANCES CHAPMAN
IN THE CITY OF GREENVILLE
GREENVILLE COUNTY S.C.
WEBB SURVEYING & MAPPING CO.
SCALE 1" = 20' OCT. 1978

BLK. BK. REF. 187-3-3A