MICROFILMED

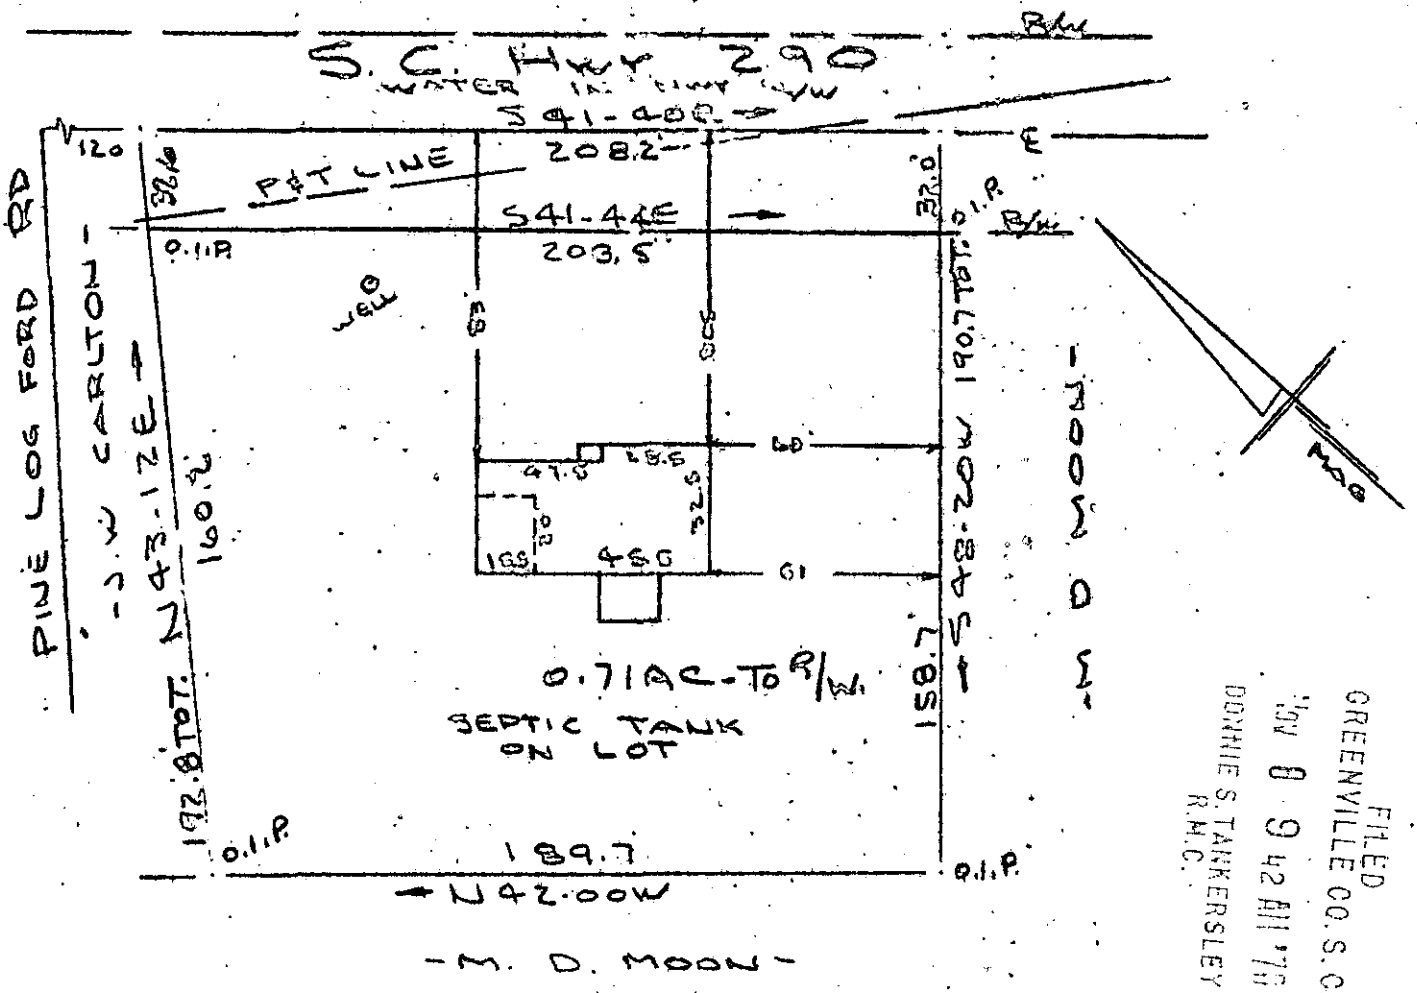

FILED
GREENVILLE CO. S.C.
NOV 8 9 42 AM '78
DONNIE S. TANKERSLEY
R.M.C.

PROPERTY OF

PHILIP D. BOWERS & SANDRA C. BOWERS

NEAR GREENVILLE, S.C

SCALE: 1" = 50' 3 NOV 1978

This to certify that on the 3rd day of November, 1978, I surveyed the property shown on this plat, being known as 0.71 acre on plat of PROPERTY OF PHILIP D. BOWERS AND SANDRA C. BOWERS and recorded in RMC Office Greenville County, S. C., in Plat Book 6X at Page 2 ; and that the property lines, walls and buildings are as shown hereon, and that the walls and buildings located on said lot do not encroach or project on adjacent street or property, and that no adjacent walls or buildings encroach or project on said premises, and no power lines cross this property except as shown hereon.

R. B. Bruce

R. B. Bruce, ALS #1952

14470

CAROLINA SURVEYING CO.
112 Manly St.
Greenville, S. C.

6X-2

SOUTH CAROLINA REGISTERED LAND SURVEYOR R. B. BRUCE

CTO
NO 8878 1113
1.00CI

210/2 6481-1-35.1