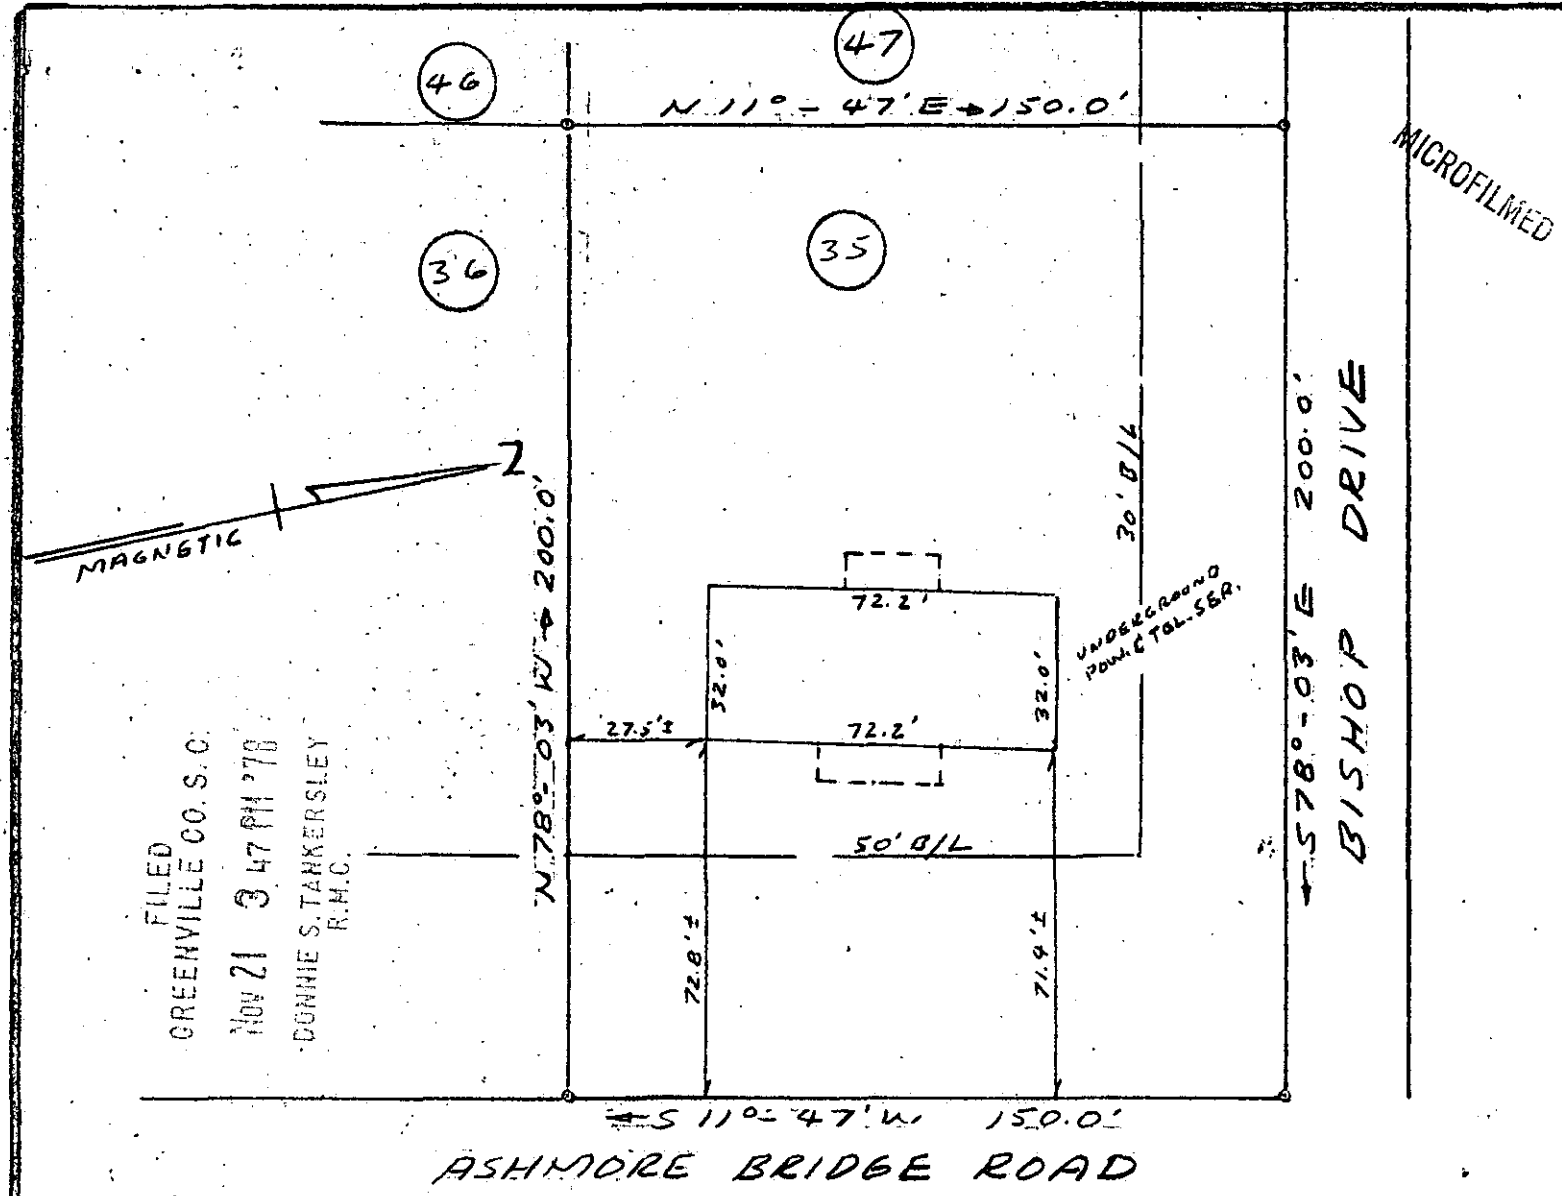

PROPERTY OF

ENOS O. BISHOP &

GENEVIEVE P. BISHOP

MAULDIN, GREENVILLE CO., S.C.

NOV. 9, 1978 SCALE: 1" = 40'

15913

This is to certify that on November 9, 1978, I surveyed the property shown on this plat, known as Lot No. 35 of Bishop Heights as shown on a plat recorded in the RMC Office for Greenville County, in Plat Book BBB, page 171, and that the property lines, walls and buildings are as shown hereon, and that the building located on said lot does not project nor encroach on adjacent streets or property, and that no adjacent walls or buildings project nor encroach on said lot, and that no utility lines cross this lot except as may be shown hereon.

✓6X-46

NOTE: This property is not located within a flood hazard area.

There is a 5' easement along all rear & side lot lines for drainage & utilities.

Survey by: Century Land Surveying Co.
Greenville, South Carolina

Richard D. Wooten, Jr.
S. C. R. L. S. No. 4678

GCTO ------ 2 NOV 21 1978 1.00CI