


MICROFILMED

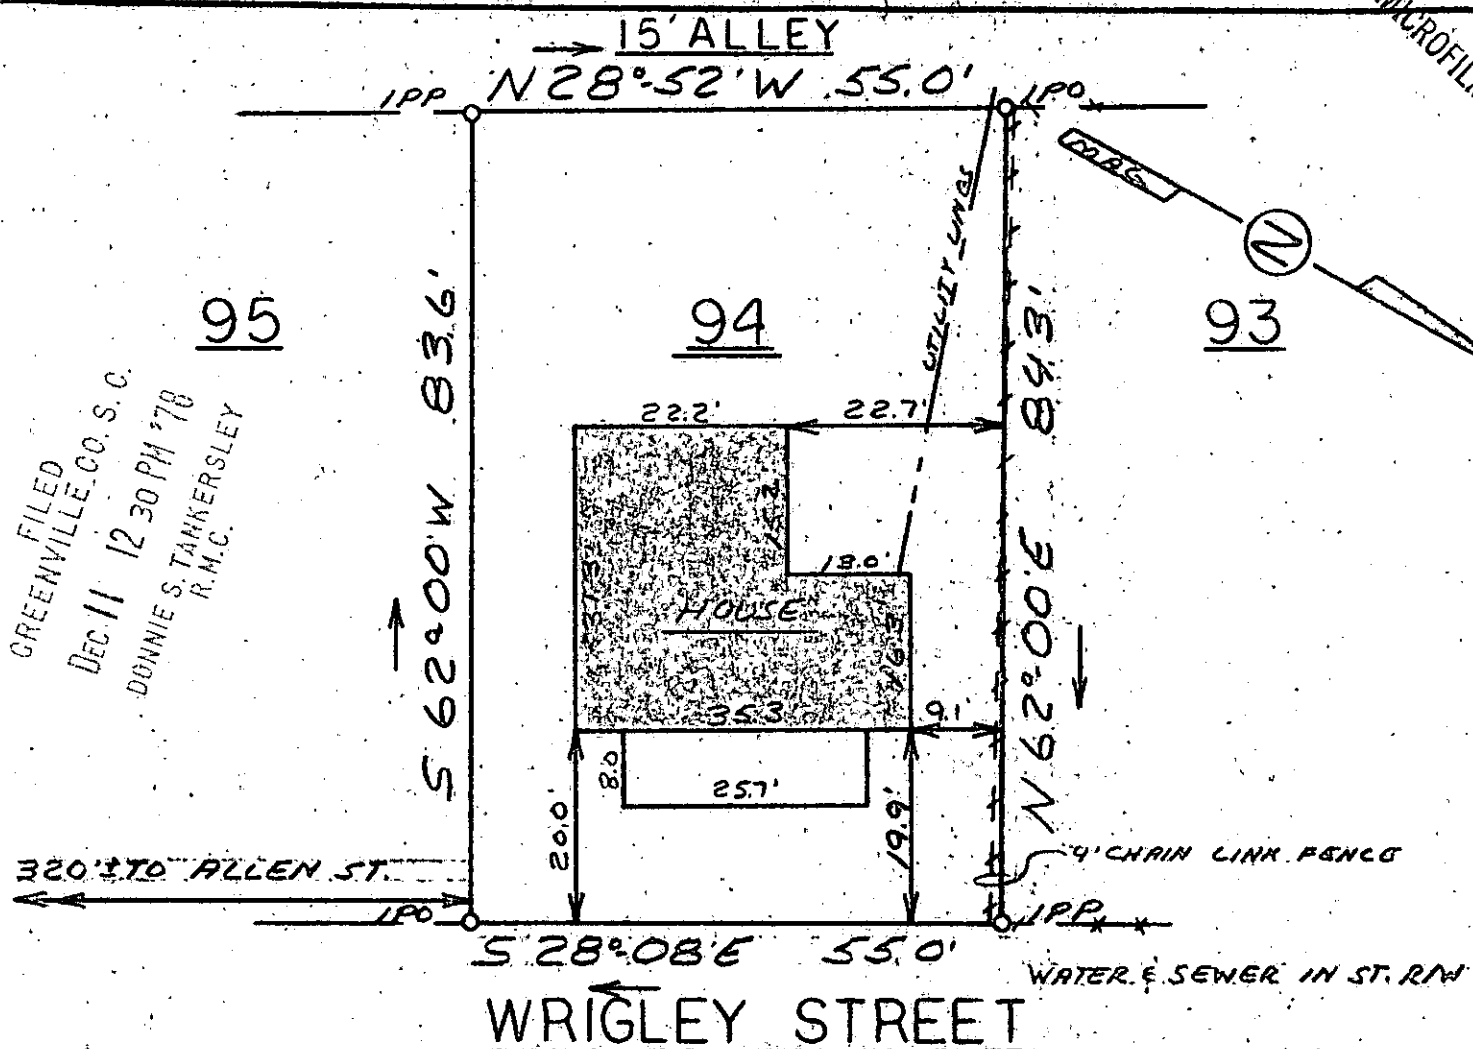

GREENVILLE CO. S.C.  
 DEC 11 12 30 PM '78  
 DONNIE S. TANKERSLEY  
 R.M.C.

This is to certify that on December 5, 1978, I surveyed the property shown on this plat, known as Lot 94 on Plat of Dunean Mills, Sec. 6, recorded in the RMC Office of Greenville County in Plat Book S on Pages 172 - 177, and that the property lines, walls and buildings are as shown hereon; that the building located on said lot does not encroach or project on adjacent streets or property, and that no adjacent walls or buildings encroach or project on said premises, and that no utility lines cross this property except as shown hereon. This property is not located in a designated flood hazard area.


DEC 11 1978

*James R. Freeland*

James R. Freeland RLS & PE 4781

✓ 6-4-96

17771

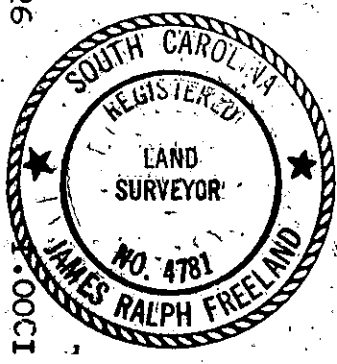

**STATE OF SOUTH CAROLINA**  
**GREENVILLE COUNTY**

DUNEAN MILLS  
SEC. 6 - LOT 94  
PROPERTY OF  
SPENCER D. COOPER  
DULA E. COOPER

**FREELAND & ASSOCIATES**  
 Engineers • Land Surveyors

GREENVILLE, S. C.

SURVEY *RP*  
 DRAWN *MC*  
 CHECK *R.P.*  
 SCALE 1"=20'  
 DATE 12-6-78  
 DWG. NO. 78-264B

DEC 11 1978

9-2-5

926

000CI

SEAL