


MICROFILMED

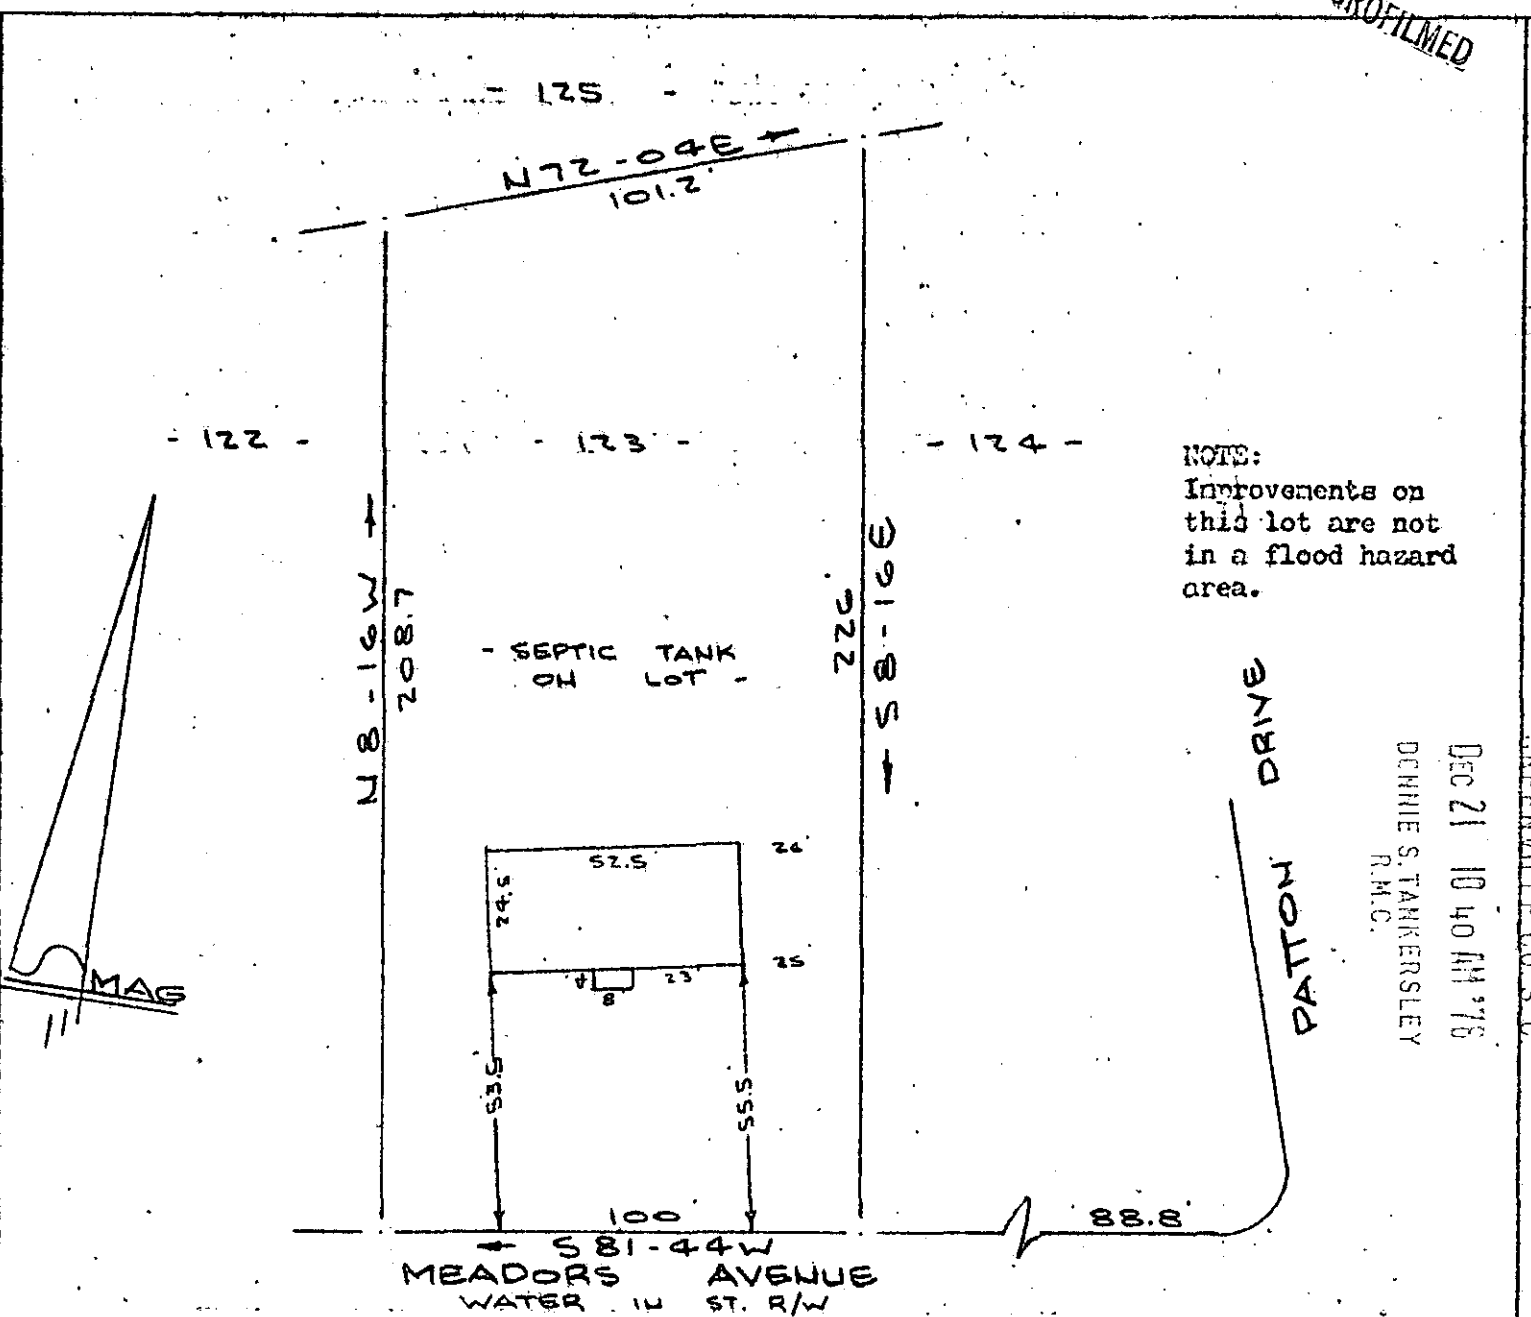

NOTE:  
Improvements on  
this lot are not  
in a flood hazard  
area.

Dec 21 10 40 AM '78  
DONNIE S. TANKERSLEY  
R.M.C.

FILED  
GREENVILLE CO. S. C.

PROPERTY OF  
**JAMES M. BUTLER & ANN GERTRUDE D. BUTLER**  
NEAR GREENVILLE, S. C.  
SCALE: 1"=40' 10 OCT 1978.

This is to certify that on the 10th day of October, 1978, I surveyed the property shown on this plat, being known as lot 123 on plat of AUGUSTA ACRES and recorded in the RMC Office Greenville County, S. C., in Plat Book " 3 " at Page 201; and that the property lines, walls and buildings are as shown hereon, and that the walls and buildings located on said lot do not encroach or project on adjacent street or property, and that no adjacent walls or buildings encroach or project on said premises, and no power lines cross this property except as shown hereon.

*D. B. Bruce*  
D. B. Bruce, RLS 1952  
SOUTH CAROLINA  
RECORDS DEPT  
NOV 15 1978  
GREENVILLE S.C.

✓ 6 Y-26

18892

CAROLINA SURVEYING CO.  
112 Main St.  
Greenville, S.C. 29615  
DEC 1 1978 1011

219/35

391-3-9