


MICROFILMED

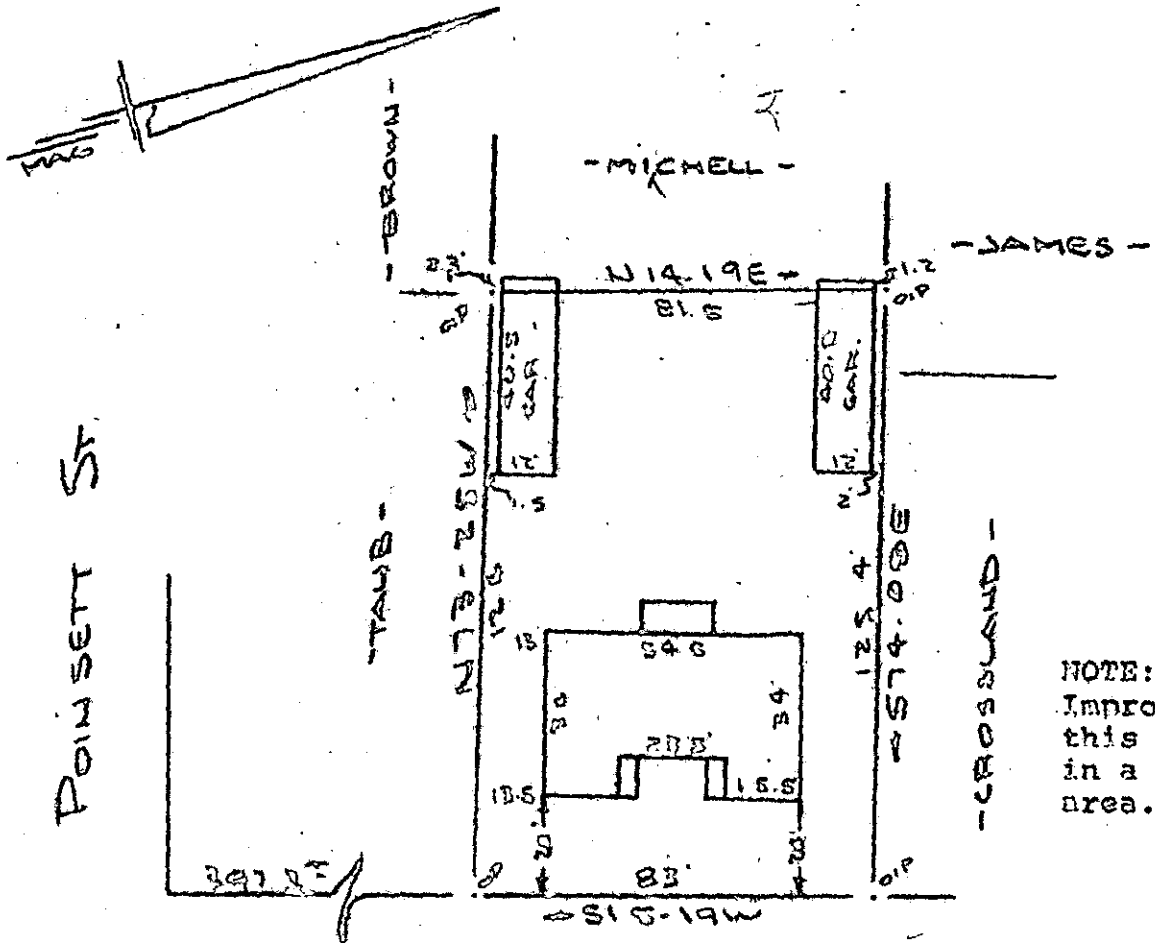

NOTE:  
 Improvements on  
 this lot are not  
 in a flood hazard  
 area.

DAVENPORT AVENUE  
 WATCH OF CENTER IN ST. SW

PROPERTY OF  
**JIMMY P. SLOAN**  
 GREER, GREENVILLE COUNTY, S.C.  
 27 DEC 1978

GREENVILLE CO. S.C.  
 JAN 4 2 28 PM '79  
 DONNIE S. TANKERSLEY  
 R.M.C.

GCTC --- 1 JA 4 79 746 1-0001

This is to certify that on the 27th day of December, 1978, I conveyed the property shown on this plat, being known as PROPERTY OF JIMMY P. SLOAN and recorded in the REC Office Greenville County, S. C., in Plat No. at Page ; and that the property lines, walls and buildings are as shown hereon, and that the walls and buildings located on said lot do not encroach or project on adjacent street or property, and that no adjacent walls or buildings encroach or project on said premises, and no power lines cross this property except as shown hereon.

16-Y-50

*R. B. Bruce*  
 R. B. Bruce, L.S.

19894

CITY OF GREENVILLE, S.C. REGISTERING

